Well Owner Information Wener Name_ <u>Second Union</u> Holdings Tailing Address: <u><u>96</u> Mark Godfrey <u>101</u> Woodhaven Dr <u>Natchez MS</u> <u>39120</u> City State Zip Code <u>Distance</u> <u>Direction</u></u>	Location " Longitude: <u>91 • 19 • 30</u> "
Well Owner Information Well Owner Information Well Owner Information Well Owner Information Well Owner Information Latitude: <u>31 · 42 · 38</u> Method of Lat/Long (circle o USGS quad, Hand-hell <u>Natchez MS 39120</u> City State Zip Code Distance Direction	
Mark Godfrey Method of Lat/Long (circle o Iailing Address: 101 Woodhaven Dr USGS quad, Hand-hele Natchez MS 39120 IR 14 5W 14 Sec IR City State Zip Code Distance	ne): Conventional Survey, d GPS, Survey-grade GPS
101 Woodhaven Dr Natchez MS 39120 City State Zip Code Distance Direction	d GPS, Survey-grade GPS
Natchez MS 39120 City State Zip Code Distance Direction	d GPS, Survey-grade GPS $9_{\text{Twn}} 9N_{\text{Rng}} 2W$
City State Zip Code Distance Direction	$9_{\text{Twn}} 9N_{\text{Rng}} 2W$
City State Zip Code Distance Direction	
	Nearest Town
Ino Ino	ot Anna 1 M3
Well Data	
Purpose of Well (circle one) Home Industrial Public Supply Irrigation Fish Culture	Other:
Date well drilling started: Date well drilling completed:	1-28-11
Method of Measurement (circle one) steel tape	
Hole depth: <u>280'</u> Well depth: <u>280'</u> Well grouted to a depth of	feet
Type of grout (circle one): Cement Bentonite Mix	PVC
	PVC
Screen length: <u>20</u> feet Screen diameter: <u>4</u> inches Type of screen:	
Screen slot size: <u>• 010</u> inches Setting depth: From <u>260</u> feet to	<u>200</u> feet
Type of completion (circle all applicable) Gravel packed Underreamed Telescoped Op	
Other (describe):	
Top of lap pipe or reduction in casing:feet. If telescoped or more than one s	
Logs run (circle all applicable): No log run Electric Gamma Ray Density Sonic Neutron	Other:
Name of organization running log(s):	le requirements of the Mississippi
I certify that the well was drilled, constructed, and completed in accordance with an application Department of Environmental Quality and/or the Mississippi Department of Health regulation	ons and state laws.
RAYBORN DRILLING, INC. $O-GO$	S
Print Name of Water Well Contractor and License No. Signatur	e of Water Well Contractor
	AUG 2 2
	- ~~~

DMI , DMLLING MACONA

STA	TE WELL REPORT	
Δ	Part 2	For Office Use Only:
County: Adams Pum	p Installer's Completion Report	
Permit #: Offi	i Department of Environmental Quality ce of Land and Water Resources	Aquifer:
	P.O. Box 10631	~ 12
Driller: Gary Kayborn	Jackson, MS 39289-0631	Well #: <u>A 13</u>
Date completed:7-2.8-11	(601)961-5210	Elevation:
-	(601)354-6938 (fax)	
This report should be prepared by the pump insta	aller in detail and filed with the Departme	nt within 30 days of the
installation of pump. Well Owner Information	We	Il Location
wher Name: Second Union Holdin	Latitude: <u>31-42-38</u>	Longitude: <u>91-19-30</u>
Mailing Address: <u>6 Mark God Fra</u>	Method of Lat/Long (circle o	ne): Conventional Survey,
101 Woodhaven Dr		d-held GPS, Survey-grade GPS
Natchez MS 391		9 Twn 9N Rng 2W
City State Zip C	Code Distance Direction	Nearest Town
Telephone No. ()	IX ENF	of Anna, MS
		·
Pump Type		ower Type
Circle one	-	Circle one
Air Lift Jet Submersit		line Engine Natural Gas
Bucket Piston Turbine	Electric Motor Hand	
Centrifugal Rotary Flowing V	Well Windmill Othe	r (specify):
Other (specify):	Horse Power Rating of Mot	or: 113 []]
0 5 1	Setting Depth:	50 <u>feet</u>
Rated Pump Capacity: Collons Pe	r Minute Number of Stages:	17
	Mathed of N	Measuring Water Level
Pump Test Data	Method of P	Circle one
Date Well Tested: 8511		
<u> </u>		Ieasuring Line Steel Tape
Static Water Level (A): $- \frac{f}{0}$ Feet Below Lan	d Surface	
	d Surface	· · · · · · · · · · · · · · · · · · ·
Pumping Water Level (B):Feet Below Land		
Drawdown [(B) - (A)]:Feet Below Lan	d Surface For flowing well, measured	I shut in head:feet
Test Pumping Rate: <u>22</u> Gallons P	D	GPM with a drawdown of
Test Pumping Rate: Callons Po		
Duration of Pump Test (minimum 4 hours):	hoursfeet afte	rhours of pumping
	us to the hest of my knowledge	
I HEREBY CERTIFY that the above statements are tr	the to the best of my knowledge.	
Gazy Rayborn 0-	60	
Print Name of Pump Installer and License No. (if appl	licable) Signature of Pum	p Installer
		الماسلال المحالي ال
		ANG 2 %
		AUL L -

If well telescopes please sketch below and show depths.




	Description of Formations Encountered	From	To
 	CHALK	0	45
•	Powdery SAND	45	50
	CLAY	50	250
	MEDIUM SAND	250	280
		_	

A13

AUG 2 2 2011

BY: OF

If more than one screen, show location of each on sketch

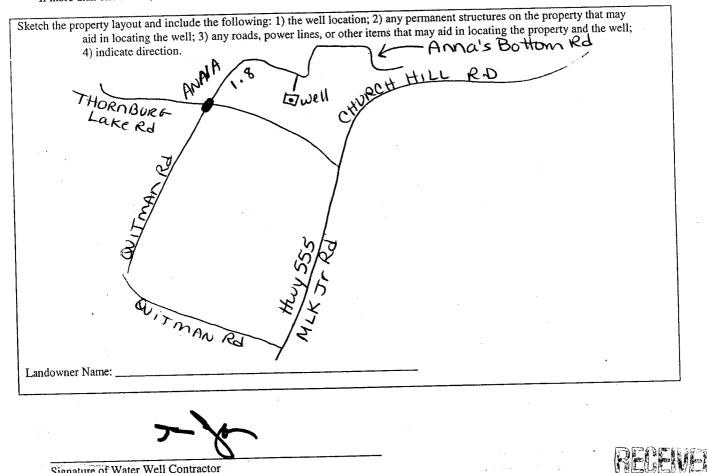

Signature of Water Well Contractor