State W	ell Report	
County: Adams Pa	For Office Use Only:	
IVISSISSIDDI Department	of Environmental Quality Aquifer: B 59	
	nd Water Resources well #:	
	S 39289-0631 L. S. Elevation:	
	061-5210	
(601)354	-6938 (fax) E-log #:	
State Law requires that this report be prepared by the 30 days of completion of drilling of the well.	driller in detail and filed with the Department within	
Well Owner Information Well Location		
Owner Name Butch Roy	Latitude: 31 .38 .09 " Longitude: 91 .16 .56 "	
	Method of Lat/Long (circle one): Conventional Survey,	
Mailing Address: 100 Hrtman Kd	USGS quad, Hand-held GPS, Survey-grade GPS	
70120	- · · · · · · · · · · · · · · · · · · ·	
Natchez MS 39120 City State Zip Code	If 1/4 If 1/4 Sec 36 Twn 8N Rng 2W	
City	Distance Direction Nearest Town NTZ 1.2 Miles N of AIRSORT,	
Telephone No. (601) 431 - 3672	I.A. Miles N of MILES OF,	
Well	Data	
Purpose of Well (circle one) Home Industrial Public Supply	Irrigation Fish Culture Other:	
Purpose of Well (circle one) (Home) Industrial Fubic Supply	12/10/10	
2	well drilling completed: 12/10/10	
If flowing, method of flow regulation: Valve Other (c	lescribe)	
Static Water Level: 120 feet above or below circle one)	land surface Date measured: 12/10/10	
Method of Measurement (circle one) steel tape electric tape	- ·	
Hole depth: 200 Well depth: 200 Well grouted to a depth of		
Type of grout (circle one): Cement Bentonite Mix	\circ	
Cosing length: 180 feet Casing diameter: 4 inches Type of casing: PVC		
Screen length: 20 feet Screen diameter: 4	inches Type of screen: PVC	
Type of completion (effects an approximate).	Arounica rossocopes of	
Top of the paper.	telescoped or more than one screen, describe on back of page	
Logs run (circle all applicable): No log run Electric Gamma Ra		
Name of organization running log(s): I certify that the well was drilled, constructed, and completed in accordance with all applicable requirements of the Mississippi		
I certify that the well was drilled, constructed, and completed in accordance with an applicable requirement of Environmental Quality and/or the Mississippi Department of Health regulations and state laws.		
Department of Environmental Quanty and/or the Mississippi Department of Frederic Togotation		
747 19 19 19 19 19 19 19 19 19 19 19 19 19	- Unchellien	
Print Name of Water Well Contractor and License No.	Signature of Water Well Karlott VED	

Print Name of Water Well Contractor and License No.

JAN 04 2011 -

STATE WELL REPORT

Part 2

Adams **Pump Installer's Completion Report** County: Mississippi Department of Environmental Quality Office of Land and Water Resources Permit #: P.O. Box 10631 Jackson, MS 39289-0631 (601)961-5210 Date completed: (601)354-6938 (fax)


For Office Use Only:	-
Aquifer:	_
Well #:	_
Elevation:	

This report should be prepared by the pump installer in detail and filed with the Department within 30 days of the installation of pump. Well Location Well Owner Information _Longitude:_9 Owner Name: Method of Lat/Long (circle one): Conventional Survey, Mailing Address: USGS quad, Hand-held GPS, Survey-grade GPS 14 Sec 36 Twn 8N Rng 2W Nearest Town Direction Distance Power Type Pump Type Circle one Circle one Natural Gas Gasoline Engine Diesel Engine Submersible Air Lift **Jet** Tractor PTO Hand Electric Motor) Piston Turbine Bucket Windmill Other (specify): _ Flowing Well Rotary Centrifugal Horse Power Rating of Motor: _ Other (specify): _ 12-10-10 Setting Depth: _ Date Pump Installed: Gallons Per Minute Number of Stages: Rated Pump Capacity: _ Method of Measuring Water Level **Pump Test Data** - Circle one 12-10-10 Date Well Tested: Electric Measuring Line Steel Tape Air Line Static Water Level (A): 120 Feet Below Land Surface Other (specify): Pumping Water Level (B): _____Feet Below Land Surface For flowing well, measured shut in head: Drawdown [(B) - (A)]: _____Feet Below Land Surface 12___GPM with a drawdown of Gallons Per Minute Well yielded Test Pumping Rate: ____ feet after _____hours of pumping Duration of Pump Test (minimum 4 hours): _____hours

I HEREBY CERTIFY that the above statements are true to the best of my knowledge. auborn Print Name of Pump Installer and License No. (if applicable) Signature of Pump Installer

JAN 0 4 2011

BY: OLWR

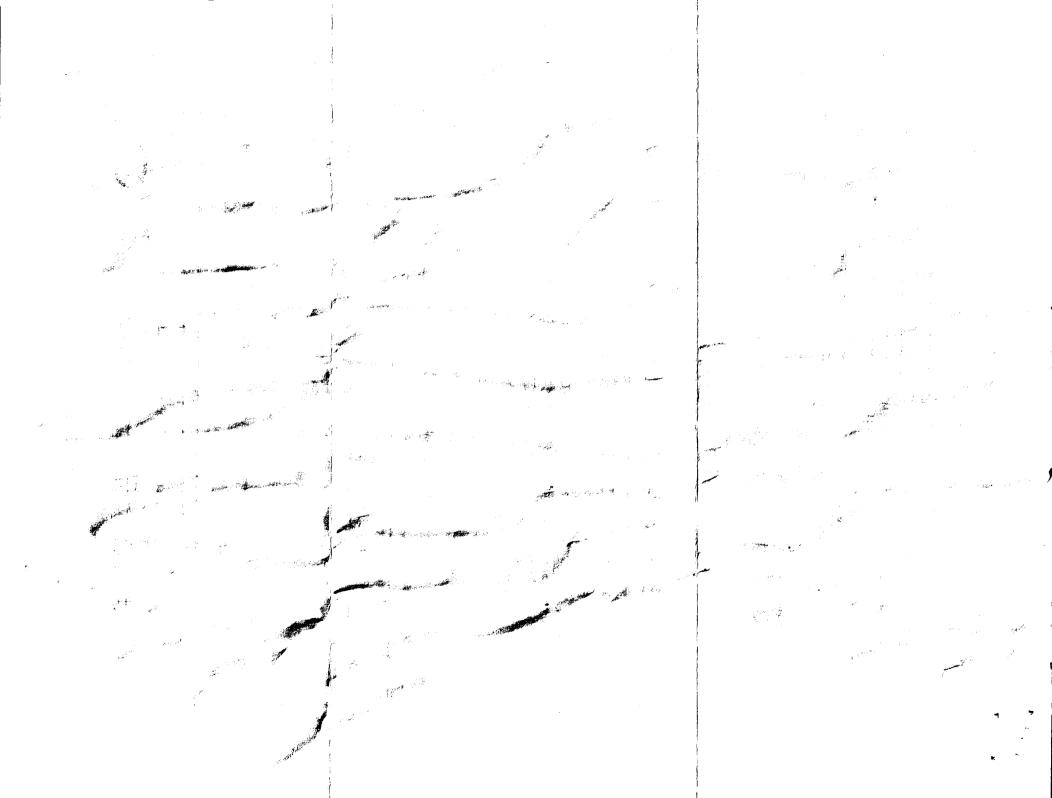

If well telescopes please sketch below and show depths.

Ground Level	

Description of Formations Encountered	From	To
CHALK	0	120
Medium SAND	120	200
<u>-</u>		
		+-

If more than one screen, show location of each on sketch

If more than one between, and a second control of the second contr
Sketch the property layout and include the following: 1) the well location; 2) any permanent structures on the property that may
Sketch the property layout and include the following. 1) the well location, 2) any permatern of a locating the property and the well; aid in locating the well; 3) any roads, power lines, or other items that may aid in locating the property and the well;
4) indicate direction.
\\\\\\\\\\\\\\\\\\\\\\\\\\\\\\\\\\\\\\
554
thuy 3
they 539
\ \alpha\circ\
to see they (0)
Pud.
ANEROLT ANDERS HWY (6)
- King Alle
upply
W.
Landowner Name:

2/2

Signature of Water Well Contractor

RECEIVED

JAN 0 4 2011

BY: OLWR

