	State Well R	eport	For Office Use Only:
County: Adams	Part 1		Aquifer:
Mis	Mississippi Department of Environmental Quality Office of Land and Water Resources		$\mathbf{D}$
priller: Gary Rayborn .	P.O. Box 100	531	
	Jackson, MS 3923 (601)961-52		L. S. Elevation:
Date drilling completed: $O[\mathcal{Z}]$	(601)354-6938		E-log #:
State Law requires that this report	be prepared by the drille	in detail and filed w	ith the Department within
30 days of completion of drilling of 1	the well.		Location
Well Owner Information			_" Longitude: <u>91 • 3 0 60</u>
Dwner Name Clint Morga			
Mailing Address: 555 HUNTING	g (ub, Inc, Meth		ne): Conventional Survey,
P.O. Box 1	621	USGS quad; Hand-hel	d GPS, Survey-grade GPS
Raceland, LA		14 IR 14 Sec 2	$6_{\text{Twn}} 8N_{\text{Rng}} 2W$
City State	Zip Code Dist	nce Direction	of Anna's Buttom
Telephone No. 985 209 - 90	218 21	25_Miles_E/SE	of MARA'S DUTION
	Well Data		
Rumose of Well (circle one Home) Indust	rial Public Supply Irrig	ation Fish Culture	Qther:
Purpose of Well (circle one Home) Indust			8211
Date well drilling started:		•	
If flowing, method of flow regulation: Valve	Other (describ	e)	8211
Static Water Level:feet abov	ve on below (circle one) land is	urface Date measured	1: 82/1
	l tape electric tape	air line other:	
$\frac{1}{2}$ $\frac{1}{2}$ $\frac{1}{2}$ $\frac{1}{2}$ $\frac{1}{2}$	2001	ell grouted to a depth o	ffeet
Hole depuit.		U	
Type of grout (circle one): Cement	1		PVC
Casing length: 180 feet Casing	diameter:in	ches Type of casing	DIC
	n diameter:ir	ches Type of screen	
Screen slot size: <u>• 010</u> inches	Setting depth: From	<u>80</u> _feet to	200 feet
	Gravel packed Underream	ed Telescoped O	pen hole Natural Development
Type of completion (encie an approxim)			
			screen, describe on back of page
Top of lap pipe or reduction in casing:			
Logs run (circle all applicable): No log run	) Electric Gamma Ray D	ensity Sonic Neuro	i Ouidi.
Name of organization running log(s): I certify that the well was drilled, constru	eted and completed in acco	rdance with all applica	ble requirements of the Mississi
I certify that the well was drilled, constru Department of Environmental Quality an	icieu, anu completeu în acco	ment of Health regulat	ions and state laws.
Department of Environmental Quality and	mor mentioner her offer	-	
RAYBORN DRILLING, INC.	0-60		
Print Name of Water Well Contractor and	License No.	Signatu	re of Water Woll Contracted U

## 

## 

RABORN DRILLING, INC. والمراجع والمتحاصين فيعدون والمتعافين والمنافع المراجع المراجع

•

a the second s

. . . . .


	LL REPORT	
County: Adams Pump Installer's	<b>Completion Report</b>	For Office Use Only:
Mississippi Departmen	t of Environmental Quality	Aquifer:
P.O.E	nd Water Resources Sox 10631	RLO
	IS 39289-0631	Well #:B63C
Data completedy (C) 1 1	961-5210 4-6938 (fax)	Elevation:
This report should be prepared by the pump installer in detai installation of pump.	l and filed with the Departmen	t within 30 days of the
Well Owner Information	Well	Location
Owner Name: Clint Morgan	Latitude: <u>31-40-23</u>	_Longitude: <u>CH - 2C - CO</u>
Mailing Address: 555 Hunting Club, Inc.	Method of Lat/Long (circle on	e): Conventional Survey,
P.O. Box 1621	USGS quad, Hand	-held GPS, Survey-grade GPS
Rareland, La 70394	<u>IR 1/4 IR 1/4 Sec 2</u>	$6 \operatorname{Twn} \frac{\partial N}{\partial N} \operatorname{Rng} 2 \omega$
City State Zip Code	Distance Direction	Nearest Town
OAT AND ANTO		Anna's Botton
Telephone No. (185) 209 - 9078	$\Delta \Delta \Delta$ Miles $\Delta \Delta \Delta$	TITUES DOLL
D	Ρο	wer Type
Pump Type Circle one		ircle one
Air Lift Jet Submersible	Diesel Engine Gasolin	ne Engine Natural Gas
Bucket Piston Turbine	Electric Motor Hand	Tractor PTO
Centrifugal Rotary Flowing Well	4	(specify):
Other (specify):		<u> </u>
Date Pump Installed: <u><u>8</u>211</u>	Setting Depth:8	<u>C</u> feet
Rated Pump Capacity: Gallons Per Minute	Number of Stages:	14
		counting Woton Loval
Pump Test Data		easuring Water Level Circle one
Date Well Tested: 0211 .	Ain Line Electric Ma	asuring Line Steel Tape
Static Water Level (A): 50 Feet Below Land Surface		
Pumping Water Level (B):Feet Below Land Surface	Other (specify):	
Drawdown [(B) - (A)]:Feet Below Land Surface	For flowing well, measured s	hut in head:feet
Test Pumping Rate:Gallons Per Minute	Well yielded	GPM with a drawdown of
Duration of Pump Test (minimum 4 hours):hours	feet after	hours of pumping
I HEREBY CERTIFY that the above statements are true to the best <u>Gary</u> Raybon 0-60 Print Name of Pump Installer and License No. (if applicable)	of my knowledge.	
Print Name of wump Instaner and License No. (If applicable)	Orginature of Family	THEUEIVE

AUG 0 8 2011 BY: OLWR If well telescopes please sketch below and show depths.



Description of Formations Encountered	From	10
 CHALK	0	150
MeDIUM SAND	150	200
CHALK	200	203
		+

If more than one screen, show location of each on sketch

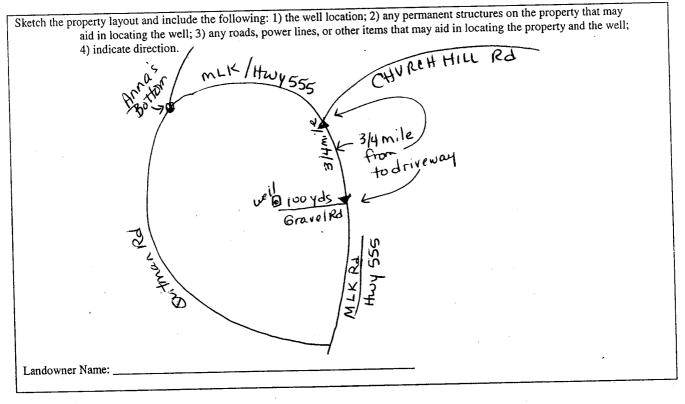

2 %

Signature of Water Well Contractor

AUG 0 8 2011

BV: O