

B 2001
7-20-60

WATER WELL DRILLERS LOG

Date: 7/20/1960, Driller: GRINDER WATER WELL SERVICE County Adams
(Name)

(1) Owner of Land: <u>W.A. Doughty</u> (Name)	Description & Color of Materials Sand, Clay, Red Clay, Shell, etc.	Thick- ness Feet	Depth Feet
<u>Pine Ridge Rd Natchez, Miss</u> (Address)	<u>TOP SOIL</u>	<u>0 to 4</u>	<u>0 to 4</u>
(2) Location: <u>1/4, 1/4, Sec. T. R.</u>	<u>Red clay</u>	<u>1 to 20</u>	<u>1 to 20</u>
<u>5</u> miles <u>N-W</u> of <u>Natchez</u> (distance) (direction) (Nearest Town)	<u>GRAVEL</u>	<u>20 to 70</u>	<u>20 to 70</u>
(3) Topography: <u>HILLY</u> (Hilly) (Flat) (Level)	<u>CRAY CLAY</u>	<u>70 to 14</u>	<u>70 to 14</u>
(4) Purpose of Well: <u>Home</u> (Domestic Irrigation Municipal, Industrial, Other)	<u>SAND</u>	<u>14 to 222</u>	<u>14 to 222</u>


Information upon completion of well:

- (1) Diameter 2 1/2 inches.
- (2) Total Depth 222 feet.
- (3) Water Level 161 feet below top of ground.
- (4) Cased to 210, Size 2 1/2
- (5) Screen: Size 2", Length 10'
- (6) Were any formations sealed against pollution?
 yes, no.

If YES depth of formation _____

Why _____

Drillers Remarks: _____

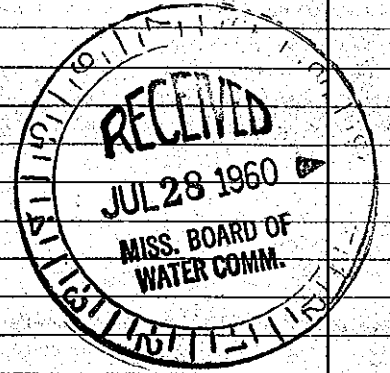

Retain this copy for your office files.

(Use Back Side)

Well No.