

B 2003

WATER WELL DRILLERS LOG

8-1-60

Date: 8/1/1960, Driller: C RIVER WATER SEED Co. County ADAMS

(Name)

	Description & Color of Materials Sand, Clay, Red Clay, Shell, etc.	Thick- ness Feet	Depth Feet
(1) Owner of Land: <u>PERNELL FLOWERS</u> (Name)	<u>TOP SOIL</u>	<u>0-6</u>	
<u>Route 2 Box 94 Natchez Miss</u> (Address)	<u>SAND</u>	<u>6-32</u>	
(2) Location: <u>1/4</u> , <u>1/4</u> , Sec. <u> </u> T. <u> </u> R. <u> </u>	<u>CLAY - GRAY</u>	<u>32-85</u>	
<u>4</u> miles <u>NORTH WEST</u> of <u>NATCHEZ</u> (distance) (direction) (Nearest Town)	<u>SAND</u>	<u>85-133</u>	
(3) Topography: <u>FLAT</u> (Hilly) (Flat) (Level)			
(4) Purpose of Well: <u>Home</u> (Domestic Irrigation Municipal, Industrial, Other)			


Information upon completion of well:

- (1) Diameter 4 inches.
- (2) Total Depth 133 feet.
- (3) Water Level 91 feet below top of ground.
- (4) Cased to 123, Size 4"
- (5) Screen: Size 4", Length 10 FT.
- (6) Were any formations sealed against pollution?
 yes, X no.

If YES depth of formation _____

Why _____

Drillers Remarks: _____

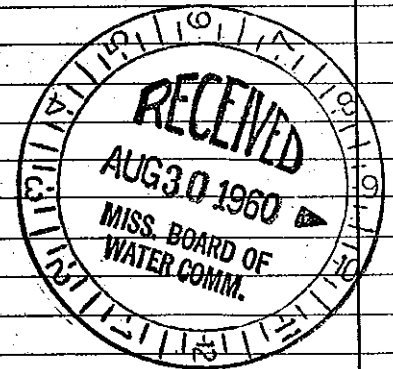

(Use Back Side)

Retain this copy for your office files.

Well No.