

B 2006

6-21-66

WATER WELL DRILLERS LOG

Date: 6/21, 1966, Driller: C. RIVER WELLS ^{SOLE} County ADAMS
(Name)

(1) Owner of Land: <u>A. D. RAND.</u> <small>(Name)</small>	Description & Color of Materials Sand, Clay, Red Clay, Shell, etc.	Thick- ness Feet	Depth Feet
<u>Route 2 Natchez, Miss</u> <small>(Address)</small>	<u>Top soil</u>	<u>1</u>	<u>1</u>
(2) Location: <u>1/4</u> , <u>1/4</u> , Sec. <u>T R</u>	<u>clay (Red)</u>	<u>20</u>	<u>21</u>
<u>5</u> miles <u>north</u> of <u>Natchez</u> <small>(distance) (direction) (Nearest Town)</small>	<u>Blue clay</u>	<u>130</u>	<u>151</u>
(3) Topography: <u>Hilly</u> <small>(Hilly) (Flat) (Level)</small>	<u>Course sand</u>	<u>38</u>	<u>189</u>
(4) Purpose of Well: <u>Home</u> <small>(Domestic Irrigation Municipal, Industrial, Other)</small>			


Information upon completion of well:

- (1) Diameter 2 inches.
- (2) Total Depth 189 feet.
- (3) Water Level 140 feet below top of ground.
- (4) Cased to 182, Size 2"
- (5) Screen: Size 2", Length 5 ft.
- (6) Were any formations sealed against pollution?
 yes, no.

If YES depth of formation _____

Why _____

Drillers Remarks: _____

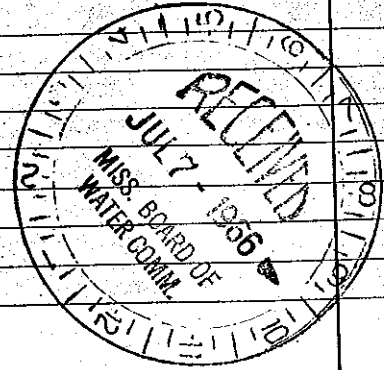

(Use Back Side)

Mail this copy to Board of Water Commissioners 429 Miss. St. Jackson, M