

C31 GW 0715
6-17-64

WATER WELL DRILLERS LOG

CODED

Date: 6-17-64 Driller: Layne-Central Co. County: Adams
(Name)

(1) Owner of Land: City of Natchez
(Name)
Natchez, Mississippi
(Address)

(2) Location: 1/4 J.B. 1/4, Sec 16 T28R3E
miles of
(distance) (direction) (Nearest Town)

(3) Topography:
(Hilly) (Flat) (Level)

(4) Purpose of Well: municipal
(Domestic Irrigation
Municipal, Industrial, Other)

Description & Color of Materials Sand, Clay, Red Clay, Shell, etc.	Thickness Feet	Depth Feet
top soil	10	0-10
clay	60	10-70
coarse sand		
& small gravel	100	70-170
pipe clay	55	170-225
hard shale	121	225-346
sand-stks		
shale	29	346-375
coarse sand	171	375-446
shale-stks		
of sand		446-452

Information upon completion of well:

(1) Diameter 16 inches.

(2) Total Depth 447 feet.

(3) Water Level 232 feet below top of ground.

(4) Cased to 375', Size 16"


(5) Screen: Size 10", Length 60"

(6) Were any formations sealed against pollution?
 yes, no.

If YES depth of formation 375'

Why required

Drillers Remarks:

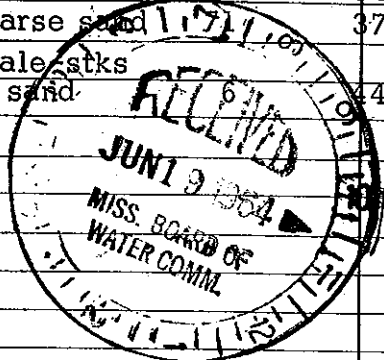

CODED

(Use Back Side)

Well No.

Mail this copy to Board of Water Commissioners 429 Miss. St. Jackson, Miss.