

C32

7-23-64

GW 746

WATER WELL DRILLERS LOG

CODED

Date: 7-23-1964, Driller: Layne-Central Co. County: Adam

C32

(Name)

(1) Owner of Land: City of Natchez (Name) Natchez, Mississippi (Address)	Description & Color of Materials Sand, Clay, Red Clay, Shell, etc.		Thick- ness Feet	Depth Feet
		top soil		
	clay	10-70	60	
(2) Location: 1/4, IR 1/4, Sec 16 T2R3	sand-gravel	70-170	100	
	pipe clay	170-225	55	
	hard shale	225-346	121	
	shale-sand	346-375	29	
(3) Topography: (Hilly) (Flat) (Level)	sand	375-446	69	
	sand-shale	446-476	30	
(4) Purpose of Well: municipal (Domestic Irrigation Municipal, Industrial, Other)	sand	476-580	104	
	shale	580-591	11	

Information upon completion of well:


- (1) Diameter 16" inches.
- (2) Total Depth 582 feet.
- (3) Water Level 218 feet below top of ground.
- (4) Cased to 510', Size 16"
- (5) Screen: Size 10", Length 60'
- (6) Were any formations sealed against pollution?
 yes, no.

If YES depth of formation 510'

Why required

Drillers Remarks:

CODED

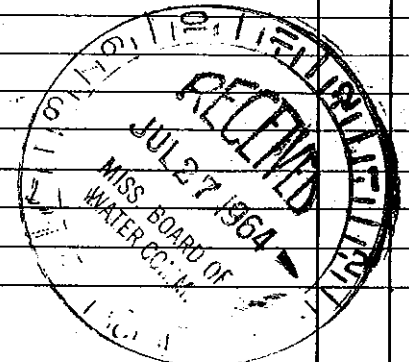

(Use Back Side)

Well No.

Mail this copy to Board of Water Commissioners 429 Miss. St. Jackson, Miss.