

C33 GW-14620

C33

WATER WELL DRILLERS LOG

CODED

Date: 2-23-1965, Driller: Layne-Central Co. County Adams
(Name)

(1) Owner of Land: Adams County Bd. of Supervisors (Name)
Natchez, Mississippi (Address)

(2) Location: 1/4, IR, 1/4, Sec 54 T. 3 N., (distance) (direction) of (Nearest Town)

(3) Topography: (Hilly) (Flat) (Level)

(4) Purpose of Well: Industrial (Domestic Irrigation Municipal, Industrial, Other)

Description & Color of Materials Sand, Clay, Red Clay, Shell, etc.	Thick-ness Feet	Depth Feet
Well No. 3		
clay	25	0-25
sand clay	8	25-33
sand-gravel	90	33-123
clay	87	123-210
hard shale-st.		
sand rock	146	210-356
clay-st sand	68	356-424
hard shale-st.		
sand	71	424-495
sand-st shale	46	495-541
sandy shale	22	541-563
clay	14	563-577
sand st. shale	44	577-621
sand	38	621-659
clay	19	659-678

Information upon completion of well:

(1) Diameter 12 inches.

(2) Total Depth 661 feet.

(3) Water Level 77 feet below top of ground.

(4) Cased to 611, Size 12"

(5) Screen: Size 8", Length 40'


(6) Were any formations sealed against pollution?
X yes, no.

If YES depth of formation 611'

Why required

Drillers Remarks:

CODED

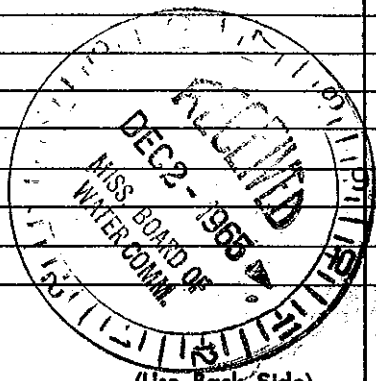

Well No.

Mail this copy to Board of Water Commissioners 429 Miss. St. Jackson, Miss.