


ADAMS MISSISSIPPI BOARD OF WATER COMMISSIONERS
 C35 GA 14622 1965
 1-12-65 WATER WELL DRILLERS LOG

CODED

Date: 1-12-1965, Driller: Layne-Central Co., County Adams
 (Name)

(1) Owner of Land: Adams County Bd. of Supervisors (Name) Natchez, Mississippi (Address)	Description & Color of Materials Sand, Clay, Red Clay, Shell, etc.		Thick-ness Feet	Depth Feet
	Well No. 1	Depth		
(2) Location: 1/4, TR 1/4, Sec 54 T2R3E, miles _____, of _____ (distance) (direction) (Nearest Town)	clay	40	0-40	
	sand & gravel	130	40-170	
(3) Topography: _____ (Hilly) (Flat) (Level)	hard clay-few			
	stks sand	98	170-268	
(4) Purpose of Well: Industrial (Domestic, Irrigation, Municipal, Industrial, Other)	sand clay	12	268-280	
	hard clay	57	280-337	
Information upon completion of well:	sand stks clay	145	337-482	
	sand	38	482-520	
(1) Diameter 12 inches.	clay-stks sand	20	520-540	
(2) Total Depth 688 feet.	fine sand-stk shale	40	540-580	
(3) Water Level 87 feet below top of ground.	sand-stks shale	57	580-637	
(4) Cased to 636', Size 12"	sand	50	637-687	
(5) Screen: Size 8", Length 40'	clay	3	687-690	
(6) Were any formations sealed against pollution? X yes, _____ no.				
If YES depth of formation 636'				
Why _____ required				
Drillers Remarks:				

CODED

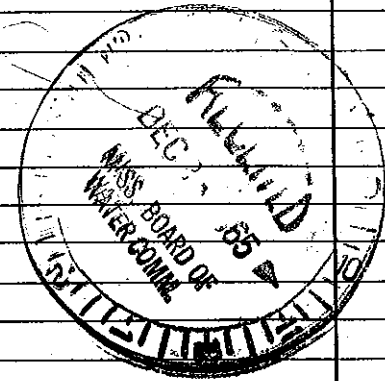

(Use Back Side)

Well No.

Mail this copy to Board of Water Commissioners 429 Miss. St. Jackson, Miss