

Adams
 C 36
 11-66
 GW 14623

MISSISSIPPI
 BOARD OF WATER COMMISSIONERS
 416 North State Street
 Jackson, Mississippi 39201
 WATER WELL DRILLERS LOG

CODED

November 17, 1966 Layne-Central Company Adams
 date well completed firm name county well located

LANDOWNER: Adams County
 Board of Supervisors,
 Diamond National Plant
~~xxxxx~~ Natchez, Mississippi
 (mailing address)

WELL LOCATION: Diamond National
 Plant ⁵⁴⁷
 sec. 27 T. 7 (N) R. 3 E
 S (W)
 1 miles SW of Natchez
 (distance) (direction) (nearest town)


WELL PURPOSE: Industrial
 (home, irrigation, municipal, industrial)

WELL COMPLETION DATA:

- (1) diameter (inches) 18"
- (2) total depth (feet) 156'
- (3) static water level (feet) 77' below
 top of ground
- (4) casing 120'
 (material) (depth)
 (size) if telescope see back.
- (5) screen 30' 120'
 (length) (depth to top)
8" stainless steel
 (size) (material)
- (6) pump 40 No test
 (HP) (yield gpm)
electric
 (type power)
- (7) electric log No
 (yes or no)
 (organization running log)
- (8) how well bottom plugged solid
bottom

description of formations encountered	from	to
Sandy Clay	0	10
White Clay	10	30
Sand & Gravel	30	68
Clay Break	68	70
Sand & Gravel	70	84
White Coarse Sand	84	98
Red Sand	98	111
Sand & Pea Gravel	114	14
Sand, Fine	140	16
Blue Clay	165	16

CODED

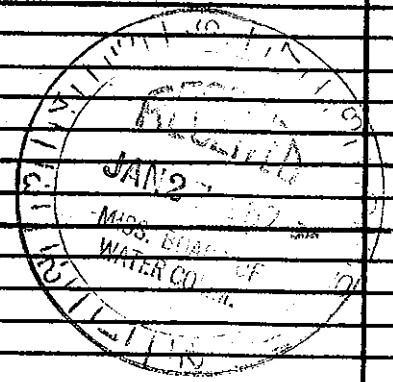

DRILLERS REMARKS: