	1 STATE	WELL REPORT	0'1	
County: Hdams		Part 1	For Office Use Only:	
Permit #:	I Mississippi Densat	Priller's Log	Well #:	
Driller: James M. Wells	Office of La	ment of Environmental Quality and and Water Resources	Aquifer:	
Date drilling completed: 7-18-18		P.O. Box 2309 on, MS 39225-2309	E-Log #:	
	,	601)961-5210		
State I an require that this		1)360-0535 (fax)		
State Law requires that this report in Department at the above address with Wall Owners information	augs of con	license holder responsible for the network of the self	he work and filed with the r borehole.	
Well Owner Information (Landowner if borehole is not for a	<u>nn</u>	Well or Bore	hole Location	
Owner Name: Jones Lum	-	Latitude: 31° 34. 31 On	gitude: 90 22.044	
Mailing Address:		31-34-21 Method of Lat/Long (check one)	01 17 . Ad	
2438 Hwy 98	E	USGS quad, Hand-held GF	S, Survey-grade GPS	
City State	39429 Zip Code		12 T TN R 3W	
Telephone No. ()		Miles of (Distance) (Direction)	(Nearest Town)	
Date drilling started: 7-18-18 Date d	Well / Bo	rehole Data	N1.11	
Location of the source of any surface w	initing completed:_	Hole depth: 105	Hole diameter:	
Location of the source of any surface wa				
Method of dosing and volume of Chlorine	used in drilling an	development: <u>Granule</u>	chlorine	
Logs run (circle all applicable) No log run	Electric Gamma	Ray Density Sonic Neutron	Other:	
Name of organization running log(s):				
Purpose of borehole (circle one): Water W			ound Source Heat PurpECE	
Seismic		escribe)	SEP 18	
If drilling is not relate	d to water well con	struction, skip the remainder of	f this block	
Purpose of Well (circle all applicable): Ho			h Culture	
Other (describe):				
If a flowing well, method of flow regulation	on: Valve	Other (describe)		
Static Water Level: <u>65</u> feet [above or <u>below</u>] land surface Date measured: <u>7-18-18</u>				
Method of measurement (circle one) Steel tape Electric tape Air line Other (describe):				
Well depth: <u>105</u> Well grouted to a depth of: <u>10</u> feet Type of grout (<i>circle one</i> : Neat Cement) Bentonite Mix				
Casing length: 75 feet Casing diameter: 4 inches Type of casing: OVC				
Screen length: \underline{JU}_{feet} feet Screen diameter: $\underline{4}_{feet}$ inches Type of screen:				
Screen slot size:				
Type of completion (circle all applicable) Gravel packed Underreamed Open hole Natural Development				
Other (describe):			activat Development	
op of lap pipe or reduction in casing:				
		screen, describe on next page		

¢

.


20

County:	Adams	
Permit #:		

	For	Office Use Only:
Well	# :	(120

The sketch below only required for water wells

If well telescopes, show depths on sketch.

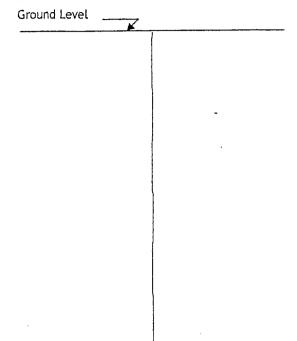

Description of formations encountered must be provided for all wells and boreholes, unless specifically exempted by regulations

Description of Formations Encountered	From (depth)	To (depth)
+2050.	Ground level	1
- Clay	1	70
Sand	70	105
	·	
	\ 	
		·····
· · · · · · · · · · · · · · · · · · ·	1	
	L	

If more than one screen, show location of each on sketch

Sketch the property layout and include the following: the well location any permanent structures on the property that may aid in locating the well any roads, power lines, or other items that may aid in locating the property and the well north arrow
RECEIVED SER 19 2018 BY OLV
Landowner Name: Sones Lumber
I HEREBY CERTIFY that the well/borehole was drilled, constructed, and completed in accordance with all applicable requirements of the Mississippi Department of Environmental Quality and the Mississippi Department of Health regulations, if applicable, and state laws. Dames IM. Wells 000058899 9-16-18 Dames IM. Constructed, and completed in accordance with all applicable Print Name of Responsible Licensee and License No. Date Signature of Licensee

Form: OLWR-SWR-1A (4/13)

	STATE W	ELL REPORT		
County: Adams		Part 2	For Office Use Only:	
Permit #:		r's Completion Report	Well #:	
Driller: James M. Wells		nent of Environmental Quality nd and Water Resources	well #:	
Date completed: 7-18-18		.О. Вох 2309 л, MS 39225-2309	Aquifer:	
Copy information from block on Part 1	(601)961-5210) 360-0535 (fax)		
This part of the report must be complete of the report must be attached and both	d by a licensed water parts filed with the L	well contractor or a licensed pur pepartment at the above address w	np installer. A copy of Part I vithin 30 days of well completion.	
Well Owner Informati			ocation	
Owner Name: Jones Lu	mber	Latitude: 31°34, 31N Lon	gitude: 40°22.04W	
Mailing Address:		Method of Lat/Long (check one): Conventional Survey,	
2438 Hwy 4	PRF.	USGS guad, Hand-held Gi		
	39429		12 T7N R3W	
City State	Zip Code			
Telephone No. ()		(Distance) (Direction)	(Nearest Town)	
	Pump Tv	pe (circle one)		
Submersible) Turbine Air Lift Centrif			scribel	
Date Pump Installed: 7-18-1				
			Gattons Per Minute	
Is This Pump (circle one): New Rep		nt pe (circle one)	<u></u>	
Electric Diesel Gasoline Natural Gas	-			
Horse Power Rating of Motor:				
Horse Power Rating of Motor:				
Date Well Tested: 7-18-18	Pump Test Data	for Non Flowing Well Duration of Pump Test (minim	num 4 hours): hours	
Static Water Level (A): 65 Fee	t Below Land Surface			
		face Test Pumping Rate:	7.5 Gallons Per Minute	
Method of measurement (circle one) St				
		ta for Flowing Well	-N/ED	
Measured shut in head:feet			RECEIVED	
Well yielded GPM with a c	Irawdown of	feet after	hours of pumping 2018	
	Meter	Installation	ANR	
Meter Manufacturer:	<u> </u>	Meter Serial Number:	<u>BYUL''</u>	
Meter Model Number/Name:		Type of Meter:		
Totalizer Register Unit and Multiplier Fa	actor (AF x .001, ga	x 1000, etc):		
Installation Date:	Meter installed by:			
Is This Meter (circle one): New Re	-			
Important: By submitting the above information you are certifying that this meter was installed to manufacturer standards.				
For agricultu	rul wells, a list of ap	proved meters is on the MDEQ w	ebsite.	
I HEREBY CERTIFY that the above states	ments are true to th	e best of my knowledge.		
	370	Quidt	· m. I. Al	
Print Name of Pump Installer and Licen	2007 se No. (if applicable	9-16-18 James Date Signa	ture of Pump Installer	

.

• •

_ ·