

WATER WELL DRILLERS LOG C-300

8-13-60

Date: 8/13, 1960, Driller: C. River Water Well County Adams

(1) Owner of Land: <u>Buckles Lease Co</u> (Name) <u>Natchez Miss</u> (Address)	Description & Color of Materials Sand, Clay, Red Clay, Shell, etc.	Thick- ness Feet	Depth Feet
(2) Location: <u>1/4</u> , <u>1/4</u> , Sec. <u> </u> T. <u> </u> R. <u> </u> <u>1</u> miles <u>NORTH</u> , of <u>Natchez</u> (distance) (direction) (Nearest Town)	<u>TOP SOIL</u>	<u>0-4</u>	
(3) Topography: <u>HILLY</u> (Hilly) (Flat) (Level)	<u>GRAY CLAY</u>	<u>4-60</u>	
(4) Purpose of Well: <u>NONE</u> (Domestic Irrigation Municipal, Industrial, Other)	<u>SAND</u>	<u>60-120</u>	
	<u>SAND GRAVEL</u>	<u>120-153</u>	


Information upon completion of well:

- (1) Diameter 2 inches.
- (2) Total Depth 153 feet.
- (3) Water Level 91 feet below top of ground.
- (4) Cased to 146, Size 2"
- (5) Screen: Size 2, Length 5'
- (6) Were any formations sealed against pollution?
 yes, X no.

If YES depth of formation _____

Why _____

Drillers Remarks: _____

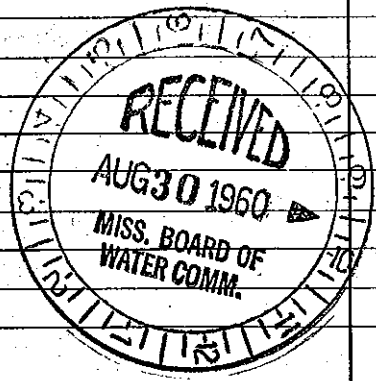

(Use Back Side)

Well No.

Retain this copy for your office files.