

ADAMS

MISSISSIPPI BOARD OF WATER COMMISSIONERS

C
1-5-61

WATER WELL DRILLERS LOG

C - 302

Date: 1-5-⁸⁷⁶⁰ 19 61, Driller: Layne-Central Co. County Adams

(Name)

(1) Owner of Land: Int'l Paper Company (Name) Natchez, Mississippi (Address)	Description & Color of Materials Sand, Clay, Red Clay, Shell, etc.		Thick- ness Feet	Depth Feet
	(2) Location: 1/4, 1/4, Sec. T7N R3W miles of (distance) (direction) (Nearest Town)	top sand		
(3) Topography: <input checked="" type="checkbox"/> (Hilly) <input checked="" type="checkbox"/> (Flat) <input type="checkbox"/> (Level)	brown clay	13	18	
(4) Purpose of Well: Industrial (Domestic Irrigation Municipal, Industrial, Other)	log	3	21	
	blue clay	33	54	
	fine sand-clay stks	32	86	
	gravel	10	96	
	fine black sand	10	106	
	coarse sand-pea gravel	53	159	
	clay break	1	160	
	coarse sand	11	171	
	hard blue clay	4	175	

Information upon completion of well:

- (1) Diameter 30 inches.
- (2) Total Depth 184 feet.
- (3) Water Level 83 feet below top of ground.
- (4) Cased to 142', Size 20"
- (5) Screen: Size 20", Length 30'

(6) Were any formations sealed against pollution?


yes, no.

If YES depth of formation 142'

Why Required

Drillers Remarks:

*159' both OK
Low land - well in casing
extended and more than
20' above 150' according
to Layne-Central*

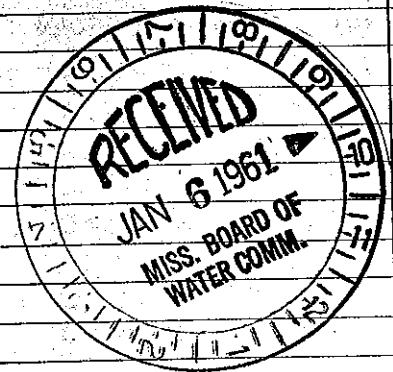

(Use Back Side)

Mail this copy to Board of Water Commissioners 429 Miss. St. Jackson, Miss.

Well No.