

C


WATER WELL DRILLERS LOG

C-305

12-1-61

Date: 12/1/1961, Driller: G. RIVER WATER WELLS, County Adams

	Description & Color of Materials Sand, Clay, Red Clay, Shell, etc.	Thick- ness Feet	Depth Feet
(1) Owner of Land: <u>PAUL GREEN</u> (Name) <u>FRY BUILDING, Natchez</u> (Address)	TOP SOIL	0	0-2 FT
	Red CLAY	2'	2-16'
	GRAY CLAY	16'	16-91'
(2) Location: <u>1/4</u> , <u>1/4</u> , Sec. <u>T</u> , R. <u>R</u> <u>1</u> miles <u>SOUTH</u> , of <u>Natchez</u> (distance) (direction) (Nearest Town)	SAND	91'	91-153'
	BLUE CLAY	153'	153-205'
	SAND	205'	205-257'
(3) Topography: <u>HILLY</u> (Hilly) (Flat) (Level)			
(4) Purpose of Well: <u>Home</u> (Domestic Irrigation Municipal, Industrial, Other)			
Information upon completion of well:			
(1) Diameter <u>2</u> inches.			
(2) Total Depth <u>257</u> feet.			
(3) Water Level <u>176</u> feet below top of ground.			
(4) Cased to <u>257</u> , Size <u>2"</u>			
(5) Screen: Size <u>2"</u> , Length <u>10 FT</u>			
(6) Were any formations sealed against pollution?			
yes, <input type="checkbox"/> no, <input checked="" type="checkbox"/>			
If YES depth of formation _____			
Why _____			
Drillers Remarks: _____			

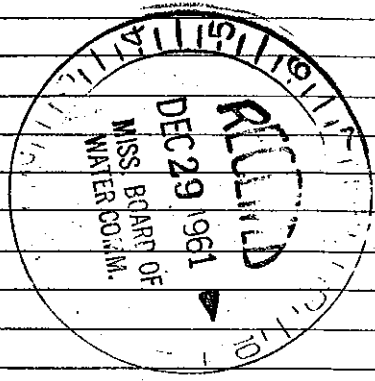

(Use Back Side)

Well No.

Mail this copy to Board of Water Commissioners 429 Miss. St. Jackson, Miss.