

2000  
7-20-60

### WATER WELL DRILLERS LOG

Date: 7/20, 1960, Driller: Greiner Water Well Service, County Adams  
 (Name)

(1) Owner of Land: David Druetta  
 (Name)  
Madgumtown Rd Natchez, Miss  
 (Address)

(2) Location: 1/4, 1/4, Sec. T R  
3 miles north, of Natchez  
 (distance) (direction) (Nearest Town)

(3) Topography: Hilly  
 (Hilly) (Flat) (Level)


(4) Purpose of Well: Home  
 (Domestic Irrigation  
 Municipal, Industrial, Other)

Description & Color of Materials Sand, Clay, Red Clay, Shell, etc.	Thick- ness Feet	Depth Feet
Top Soil	0-4	4
Red Clay	4-30	30
Clay Gray Sand	30-100	100
	100-175	175

#### Information upon completion of well:

- (1) Diameter 2 inches.
- (2) Total Depth 175 feet.
- (3) Water Level 105 feet below top of ground.
- (4) Cased to 168, Size 2"
- (5) Screen: Size 2", Length 5'
- (6) Were any formations sealed against pollution?  
no

If YES depth of formation \_\_\_\_\_  
 Why \_\_\_\_\_  
 Drillers Remarks: \_\_\_\_\_

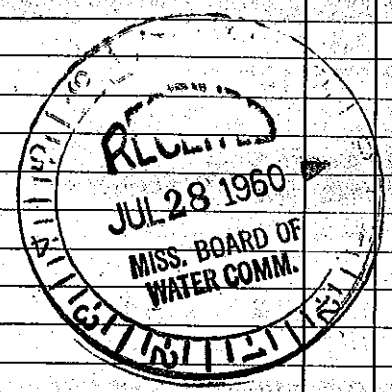

Retain this copy for your office files.

(Use Back Side)

Well No.