

C.D. 2002


10-4-60

WATER WELL DRILLERS LOG

Date: 10/4, 1960, Driller: CRINER WATER WELL SERVICE County ADAMS

(Name)

	Description & Color of Materials Sand, Clay, Red Clay, Shell, etc.	Thick- ness Feet	Depth Feet
(1) Owner of Land: <u>A. Souders</u> (Name)	TOP SOIL	0-4	4
<u>MORGANTOWN Rd - Natchez</u> (Address)	Red clay	4-30	30
(2) Location: <u>1/4, 1/4, Sec. T R</u>	CLAY CLAY	30-60	60
<u>3</u> miles <u>NORTH</u> of <u>Natchez</u> (distance) (direction) (Nearest Town)	SAND	60-169	169
(3) Topography: <u>Hilly</u> (Hilly) (Flat) (Level)			
(4) Purpose of Well: <u>Domestic</u> (Domestic Irrigation Municipal, Industrial, Other)			
Information upon completion of well:			
(1) Diameter <u>2</u> inches.			
(2) Total Depth <u>169</u> feet.			
(3) Water Level <u>132</u> feet below top of ground.			
(4) Cased to <u>162</u> , Size <u>2"</u>			
(5) Screen: Size <u>2"</u> , Length <u>5'</u>			
(6) Were any formations sealed against pollution?			
_____ yes, <u>A</u> no.			
If YES depth of formation _____			
Why _____			
Drillers Remarks: _____			

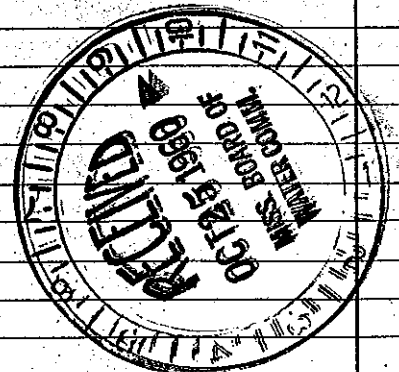

(Use Back Side)

Well No.

Mail this copy to Board of Water Commissioners 429 Miss. St. Jackson, Mis