

C 2003
10-14-60

WATER WELL DRILLERS LOG

Date: 10/14, 1960, Driller: C. Rider Water Well Co. County Adams

		Description & Color of Materials Sand, Clay, Red Clay, Shell, etc.	Thick- ness Feet	Depth Feet
(1) Owner of Land: <u>Buckles Bros. Land</u> (Name)				
<u>Pine Ridge Rd Natchez</u> (Address)		TOP SOIL	0-4	
		Red CLAY	4-20	
(2) Location: <u>1/4, 1/4, Sec. T. R.</u>		GRAY CLAY	20-90	
<u>2 miles N.W. 1/4</u> , of <u>NATCHEZ</u> (distance) (direction) (Nearest Town)		SAND	90-133	
(3) Topography: <u>HILLY</u> (Hilly) (Flat) (Level)				
(4) Purpose of Well: <u>Home</u> (Domestic Irrigation Municipal, Industrial, Other)				


Information upon completion of well:

- (1) Diameter 2 inches.
- (2) Total Depth 133 feet.
- (3) Water Level 92 feet below top of ground.
- (4) Cased to 126, Size 2"
- (5) Screen: Size 2", Length 5
- (6) Were any formations sealed against pollution?
yes, no.

If YES depth of formation _____

Why _____

Drillers Remarks: _____

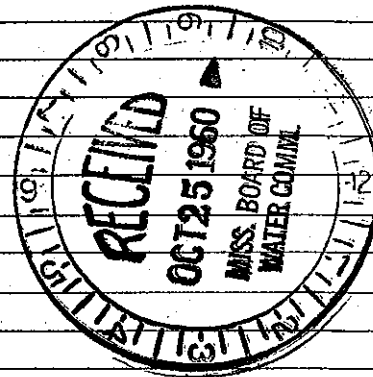

(Use Back Side)

Well No.

Mail this copy to Board of Water Commissioners 429 Miss. St. Jackson, Miss.