

Date: 1-5-1961, Driller: Layne-Central Co. County Adams
 9/60 (Name)

(1) Owner of Land: Int'l Paper Company (Name) Natchez, Mississippi (Address)	Description & Color of Materials Sand, Clay, Red Clay, Shell, etc.	Thick- ness Feet	Depth Feet
	top soil	5	5
	sandy clay	5	10
	brown clay, soft	8	18
	hard blue clay	12	30
	blue clay, soft	25	55
	soft clay-sand strks	14	69
	fine sand-soft clay	35	104
	hard clay	6	110
	sand & clay streaks	18	128
	gravel & coarse sand	36	164
	white clay	11	175

(2) Location: 1/4, 1/4, Sec. T R
 miles of
 (distance) (direction) (Nearest Town)

(3) Topography: (Hilly) (Flat) (Level)


(4) Purpose of Well: Industrial
 (Domestic Irrigation
 Municipal, Industrial, Other)

Information upon completion of well:

(1) Diameter 30 inches.
 (2) Total Depth 184 feet.
 (3) Water level 83 feet below top of ground.
 (4) Cased to 142', Size 20"
 (5) Screen: Size 20", Length 30'
 (6) Were any formations sealed against pollution?
 X yes, no.

If YES depth of formation 142'
 Why Required
 Drillers Remarks:

*Use depth of
 164' well in
 Louisiana and casing
 extended about
 20' above used
 according to
 Layne-Central
 (BZ)*

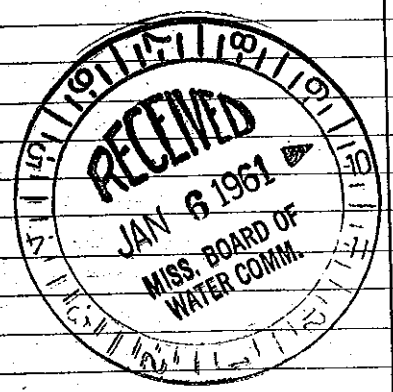

(Use Back Side)

Mail this copy to Board of Water Commissioners 429 Miss. St. Jackson, Miss

Well No.