

MISSISSIPPI DEPARTMENT OF ENVIRONMENTAL QUALITY  
 Office of Land and Water Resources  
 P. O. Box 2309  
 Jackson, MS 39225  
 Water Well Plugging/Decommissioning Form  
 OLWR-DF-1 (04/08)

DI

COUNTY WELL LOCATED: Adams	WELL NUMBER: 4-GW02089
PERMIT NUMBER: MS-GW-02089	DATE WELL PLUGGED: 7-10-2019
NAME OF FIRM PLUGGING WELL: Rayborn Drilling Inc.	TELEPHONE NUMBER: 601-445-8930
NAME AND ADDRESS OF CURRENT LANDOWNER: Mississippi Power & Light Co. PO Box 1640 Jackson MS 39215	
WELL LOCATION: SECTION: 12 TOWNSHIP: 7N RANGE: 2W	
WELL LOCATION: LATITUDE: 31.6009 LONGITUDE: -91.3392	METHOD (CIRCLE ONE): (1) USGS QUAD (2) CONVENTIONAL SURVEY (3) GPS - HAND HELD OR SURVEY GRADE
DISTANCE: 4 m. DIRECTION: NW NEAREST TOWN: Washington OTHER LANDMARK:	
WELL PURPOSE (HOME, IRRIGATION, MUNICIPAL, ETC.): Industrial	
NAME OF WELL CONTRACTOR WHO DRILLED THE WELL: Unknown	
NAME OF LANDOWNER WHEN WELL WAS DRILLED: Mississippi Power & Light Co.	


RECEIVED  
 JUL 22 2019  
 BY OLWR

WELL DATA			
WELL DEPTH: 451'	HOLE DEPTH: 451'		
CASING DIAMETER (IN.): 16	CASING LENGTH (FT.): 241	TYPE OF CASING: welded steel	
DEPTH TO STATIC WATER LEVEL: 140'	DATE WELL COMPLETED: 1/1/1949		
WHY IS THE WELL BEING ABANDONED? Plant closing			

DESCRIBE HOW THE WELL OR HOLE WAS PLUGGED (AMOUNT OF CASING AND/OR SCREEN THAT WAS REMOVED OR LEFT IN HOLE, MATERIAL AND AMOUNT USED IN PLUGGING, METHOD OF PLACING MATERIAL, ETC.)

Screen and casing were left in hole. Filled screen with sand. Ran trimmie pipe to top of sand in screen. Pumped 225 sacks of cement with 8% gel to surface. Cut casing off below grade and backfilled.

I CERTIFY THAT THE WELL WAS PLUGGED OR ABANDONED IN ACCORDANCE WITH THE STATE OF MISSISSIPPI REGULATIONS.

<u>Gary Rayborn</u>	<u>60</u>
PRINT NAME	MS LICENSE NUMBER
	<u>7-16-19</u>
SIGNATURE	DATE

RECEIVED

JUL 22 2019

PLUGGED

31° 37' 30"

3499000m N.

T 8 N  
T 7 N

3498


3497

3496

35'

3495

3494

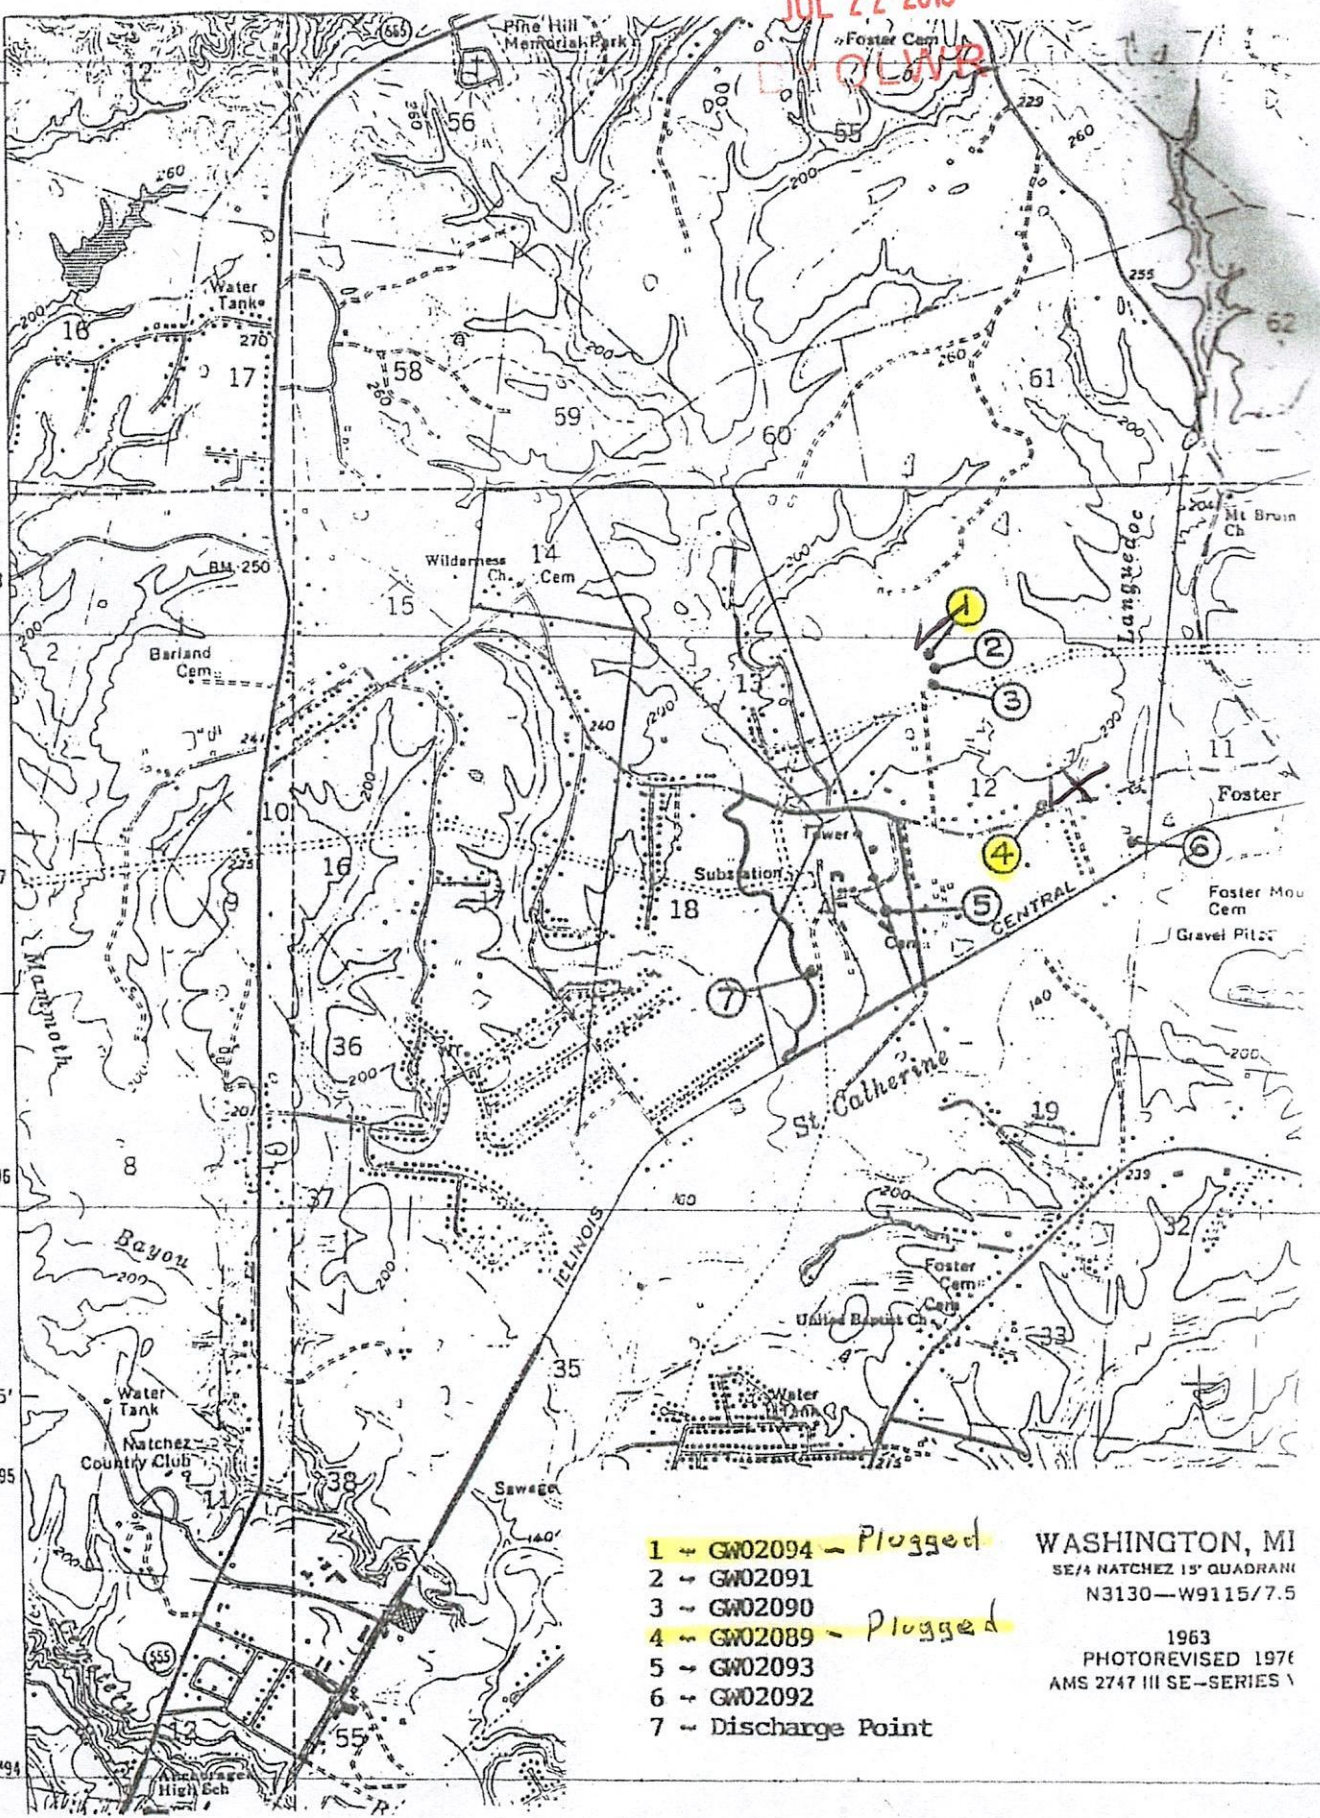

- 1 - GW02094 - Plugged
- 2 - GW02091
- 3 - GW02090
- 4 - GW02089 - Plugged
- 5 - GW02093
- 6 - GW02092
- 7 - Discharge Point

WASHINGTON, MI  
 SE 1/4 NACHEZ 15' QUADRANT  
 N3130 - W9115 / 7.5  
 1963  
 PHOTOREVISED 1976  
 AMS 2747 III SE - SERIES A