

MISSISSIPPI DEPARTMENT OF ENVIRONMENTAL QUALITY
Office of Land and Water Resources
P. O. Box 2309
Jackson, MS 39225
Water Well Plugging/Decommissioning Form
OLWR-DF-1 (04/08)

D52

COUNTY WELL LOCATED: <u>Adams</u>		WELL NUMBER: <u>1-GW02094</u>
PERMIT NUMBER: <u>MS-GW-02094</u>	DATE WELL PLUGGED: <u>7/9/2019</u>	
NAME OF FIRM PLUGGING WELL: <u>Rayborn Drilling Inc.</u>	TELEPHONE NUMBER: <u>601-445-8930</u>	
NAME AND ADDRESS OF CURRENT LANDOWNER: <u>Mississippi Power & Light Co.</u> <u>PO Box 1640</u> <u>Jackson MS 39215</u>		
WELL LOCATION: SECTION: <u>12</u> TOWNSHIP: <u>7N</u> RANGE: <u>2W</u>		
WELL LOCATION: LATITUDE: <u>31.6047</u> LONGITUDE: <u>-91.3430</u>	METHOD (CIRCLE ONE): (1) USGS QUAD (2) CONVENTIONAL SURVEY (3) GPS - HAND HELD OR SURVEY GRADE	
DISTANCE: <u>4 m.</u> DIRECTION: <u>NW</u> NEAREST TOWN: <u>Washington</u> OTHER LANDMARK:		
WELL PURPOSE (HOME, IRRIGATION, MUNICIPAL, ETC.): <u>Industrial</u>		
NAME OF WELL CONTRACTOR WHO DRILLED THE WELL: <u>Rayborn Drilling</u>		
NAME OF LANDOWNER WHEN WELL WAS DRILLED: <u>Mississippi Power & Light Co.</u>		


RECEIVED
JUL 22 2019
BY OLWR

WELL DATA		
WELL DEPTH: <u>397'</u>	HOLE DEPTH: <u>397'</u>	
CASING DIAMETER (IN.): <u>12</u>	CASING LENGTH (FT.): <u>392</u>	TYPE OF CASING: <u>welded stainless</u>
DEPTH TO STATIC WATER LEVEL: <u>135'</u>	DATE WELL COMPLETED: <u>7/1/1981</u>	
WHY IS THE WELL BEING ABANDONED? <u>Plant closing</u>		

DESCRIBE HOW THE WELL OR HOLE WAS PLUGGED (AMOUNT OF CASING AND/OR SCREEN THAT WAS REMOVED OR LEFT IN HOLE, MATERIAL AND AMOUNT USED IN PLUGGING, METHOD OF PLACING MATERIAL, ETC.)

Screen and casing were left in hole.
Filled screen with sand. Ran trimmie pipe to top of sand in screen. Pumped 150 sacks of cement with 8% gel to surface. Cut casing off below grade.

I CERTIFY THAT THE WELL WAS PLUGGED OR ABANDONED IN ACCORDANCE WITH THE STATE OF MISSISSIPPI REGULATIONS.

<u>Gary Rayborn</u>	<u>60</u>
PRINT NAME	MS LICENSE NUMBER
	<u>7-16-19</u>
SIGNATURE	DATE

RECEIVED

JUL 22 2019

D. OLIVER

31°37'30"

3499000m N.

T 8 N

T 7 N

3498


3497

3496

35'

3495

3494

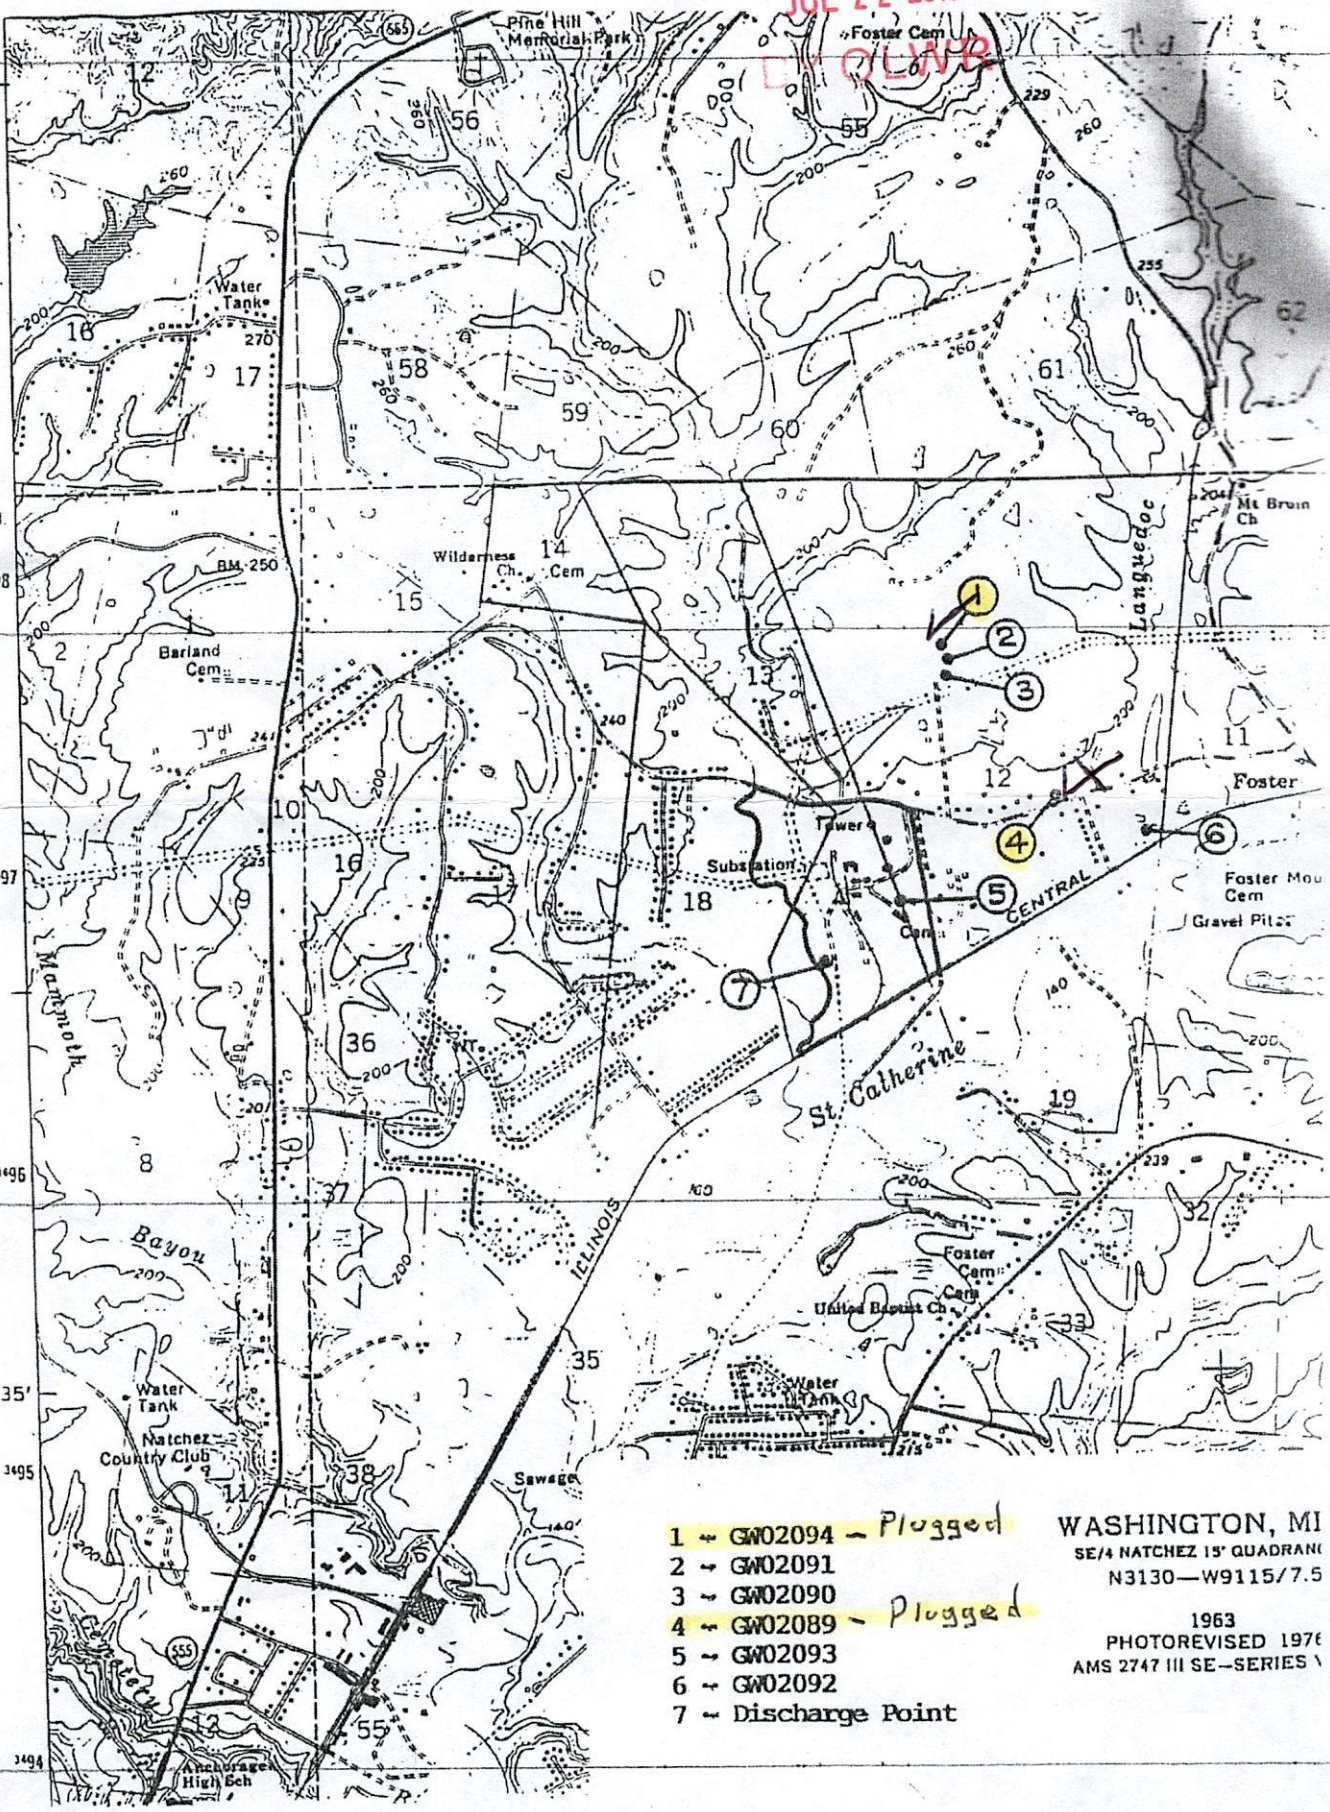

- 1 - GW02094 - Plugged
- 2 - GW02091
- 3 - GW02090
- 4 - GW02089 - Plugged
- 5 - GW02093
- 6 - GW02092
- 7 - Discharge Point

WASHINGTON, MI
SE/4 NACHEZ 15' QUADRANT
N3130—W9115/7.5
1963
PHOTOREVISED 1976
AMS 2747 III SE—SERIES A