

D 2000

# WATER WELL DRILLERS LOG

8-17-60

Date: 8/17, 1960, Driller: CRIDER WATERWELL County ADAMS

		Description & Color of Materials Sand, Clay, Red Clay, Shell, etc.	Thick- ness Feet	Depth Feet
(1) Owner of Land:	LEROY WHEAT (Name)	TOP SOIL	0-4	
	HIWAY 61 NORTH MATCHAZ (Address)	RED CLAY	4-12	
		GRAY CLAY	12-78	
		SAND	78-15	

(2) Location: 1/4, 1/4, Sec. T. R.

2 miles NORTH of MATCHAZ  
(distance) (direction) (Nearest Town)


(3) Topography: HILLY  
(Hilly) (Flat) (Level)

(4) Purpose of Well: SERVICE STATION  
(Domestic Irrigation  
Municipal, Industrial, Other)

### Information upon completion of well:

- (1) Diameter 2 inches.
- (2) Total Depth 157 feet.
- (3) Water Level 112 feet below top of ground.
- (4) Cased to 149, Size 2"
- (5) Screen: Size 2", Length 6'
- (6) Were any formations sealed against pollution?  
yes, 1 no.

If YES depth of formation  
Why  
Drillers Remarks:

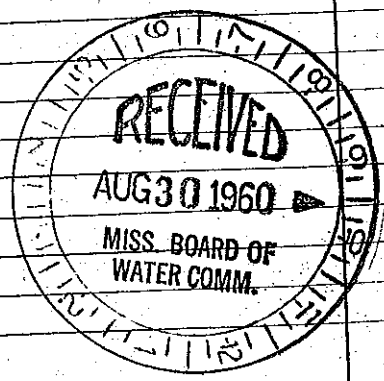

(Use Back Side)

Mail this copy to Board of Water Commissioners 429 Miss. St. Jackson, Mi.

Well No.