

MUTUAL

D 2002
8-2-62

WATER WELL DRILLERS LOG


Forest Drilling

Adams

Date: 7/30 to 8/2 1962, Driller: James McGee, County: Hinds

(Name)

	Description & Color of Materials Sand, Clay, Red Clay, Shell, etc.	Thick- ness Feet	Depth Feet
(1) Owner of Land: <u>E. D. Liles</u> (Name)	Brown clay.		27- 27
<u>Learned, Miss.</u> (Address)	Blue clay.		40- 67
Take Hwy. 18 out of Jackson go to (2) Location: <u>1/4</u> , <u>1/4</u> , Sec. <u>T</u> , <u>R</u> Old Port Gibson road. Go Old Port	Clay & fine sand.		5- 72
Gibson rd. to Natchez Trace rd. turn miles <u> </u> of <u> </u> (distance) (direction) (Nearest Town)	Clay.		65-137
left just before you get into Natchez (3) Topography: <u>X</u> (Hilly) (Flat) (Level)	Clay & stks. rock.		10-147
Trace. First chicken farm on left. (4) Purpose of Well: <u>Domestic</u> (Domestic Irrigation Municipal, Industrial, Other)	Clay & stks. shell.		10-157
Information upon completion of well:	Rock.		10-167
(1) Diameter <u>2</u> inches.	Clay.		5-172
(2) Total Depth <u>291</u> feet.	Rock.		42-214
(3) Water Level <u>28</u> feet below top of ground.	Clay.		3-217
(4) Cased to <u>280'</u> , Size <u>2"</u>	Fine sand & shell.		13-230
(5) Screen: Size <u>2"</u> , Length <u>11'</u>	Clay.		17-247
(6) Were any formations sealed against pollution? <u> </u> yes, <u>X</u> no.	Fine sand & stks. clay.		10-257
If YES depth of formation <u> </u>	Clay.		15-272
Why <u> </u>	Rock.		5-277
Drillers Remarks: <u>Good well.</u>	Clay.		4-281
	Sand. (Screen setting.)		10-291
	Clay & rock		6-297
	Soft shale & rock.		10-307

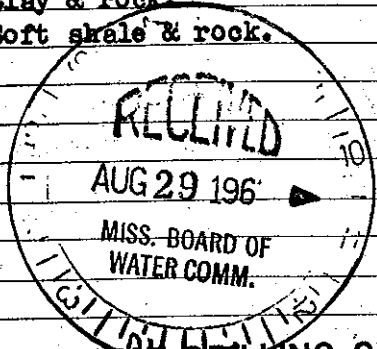

FOREST DRILLING SERVICE
P. O. Box 5717
PEARL BRANCH
JACKSON 8, MISS.

(Use Back Side)

Well No.

Mail this copy to Board of Water Commissioners 429 Miss. St. Jackson, Miss.