

ADAMS
D 2003
11-5-62

WATER WELL DRILLERS LOG

Date: 11-5, 1962, Driller: Herring Pump & Tank
(Name)

	Description & Color of Materials Sand, Clay, Red Clay, Shell, etc.	Thick- ness Feet	Depth Feet
(1) Owner of Land: <u>J. A. Marlow</u> (Name)	<u>40' clay</u>	<u>40</u>	
<u>Watches Miss</u> (Address)	<u>band</u>	<u>105</u>	
(2) Location: <u>1/4</u> , <u>1/4</u> , Sec. <u>T</u> <u>R</u>			
<u>4</u> miles <u>E</u> of <u>Watches</u> (distance) (direction) (Nearest Town)			
(3) Topography: _____ (Hilly) (Flat) (Level)			
(4) Purpose of Well: <u>Domestic</u> (Domestic Irrigation Municipal, Industrial, Other)			

Information upon completion of well:

(1) Diameter 4 3/4 inches.

(2) Total Depth 145 feet.

(3) Water Level 130 feet below top of ground.

(4) Cased to 138, Size 2"


(5) Screen: Size 2", Length 5'

(6) Were any formations sealed against pollution?
_____ yes, C no.

If YES depth of formation _____

Why _____

Drillers Remarks: _____

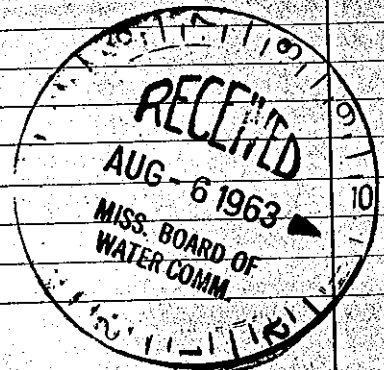

(Use Back Side)

Well No.

Mail this copy to Board of Water Commissioners 429 Miss. St. Jackson, Miss