

ADAMS MISS.

E 2000

WATER WELL DRILLER LOG

10-29-60

Date: 10/29, 1960, Driller: G. RIVER WATER WELL SERVO. County ADAMS

(Name)

(1) Owner of Land: JOE PAINP (Name)

NATCHIZ, MISS (Address)

(2) Location: 1/4, 1/4, Sec. T7R1W

7 miles EAST of NATCHIZ (distance) (direction) (Nearest Town)

(3) Topography: HILLY (Hilly) (Flat) (Level)

(4) Purpose of Well: HOME (Domestic Irrigation Municipal, Industrial, Other)

Description & Color of Materials Sand, Clay, Red Clay, Shell, etc.

Thick-ness Feet

Depth Feet

TOP SOIL	0-3	
RED CLAY	3-10	
GRAVEL	10-12	
GRAY CLAY	12-78	
SAND	78-112	

Information upon completion of well:

(1) Diameter 7 inches.

(2) Total Depth 112 feet.

(3) Water Level 82 feet below top of ground.

(4) Cased to 100, Size 2"

(5) Screen: Size 2", Length 15'


(6) Were any formations sealed against pollution?

yes, no.

If YES depth of formation

Why

Drillers Remarks:

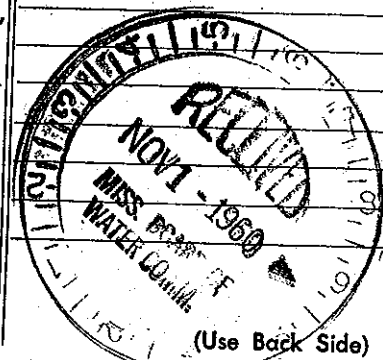

Well No.

Mail this copy to Board of Water Commissioners 429 Miss. St. Jackson, Miss.