

MISSISSIPPI DEPARTMENT OF ENVIRONMENTAL QUALITY  
Office of Land and Water Resources

P. O. Box 10631  
Jackson, MS 39289-0631  
WATER WELL DRILLERS LOG

COUNTY WELL LOCATED <b>Adams</b>	
WELL NUMBER <b>E 2020</b>	CODED
DATE WELL COMPLETED <b>7-25-94</b>	

PERMIT NUMBER <b>0-60</b>
NAME OF DRILLING FIRM <b>Rayburn Drilling Natchez, ms</b>

NAME & MAILING ADDRESS OF LANDOWNER <b>Willie Willard 156 Cardinal Rd. Natchez, ms</b>			
WELL LOCATION	SEC	TOWNSHIP	RANGE
	<b>55</b>	<b>7</b>	<b>S 1</b>
DISTANCE	DIRECTION	NEAREST TOWN	
<b>1</b> Miles	<b>SE</b>	<b>Jenrich</b>	
OTHER LANDMARK			
WELL PURPOSE: Home, Irrigation, Municipal, Industrial, Fish Pond, etc. <b>Pond</b>			

PUMP DATA		
PUMP TYPE (Circle One): <input checked="" type="checkbox"/> Submersible    Turbine    Jet    Flowing Well Other (Describe)		
POWER TYPE (Circle One): <input checked="" type="checkbox"/> Electric    Tractor    Diesel    Gasoline    Butane Other (Describe) <b>1 1/2</b> H/P		
Pump Capacity (GPM) <b>30</b>	No. of Stages	Setting Depth <b>30</b> FT.
PUMP TEST		
Well yielded _____ GPM with a drawdown of _____ ft. after _____ hours of pumping		


WELL DATA		
Well Depth <b>83'</b>	Casing Diameter (In.) <b>4"</b>	Casing Length (Ft.) <b>73'</b>
Type of Casing <b>PVC</b>	Hole Depth <b>83'</b>	Depth to Static Water Level <b>50'</b>
TYPE OF COMPLETION: (Circle One or More): <input checked="" type="checkbox"/> Gravel Packed <input type="checkbox"/> Underreamed <input type="checkbox"/> Telescoped <input checked="" type="checkbox"/> Natural Development <input type="checkbox"/> Open Hole <input type="checkbox"/> Other (Describe)		
WELL GROUTED TO A DEPTH OF _____ FEET Type Grout (circle one): Cement, Bentonite, or Mix		

LOG DATA	
TYPE OF LOG RUN (Circle One): <input type="checkbox"/> No Log Run <input type="checkbox"/> Electric <input type="checkbox"/> Gamma Ray <input type="checkbox"/> Density <input type="checkbox"/> Sonic <input type="checkbox"/> Neutron Other (Describe)	
Name of Organization Running Log	

SCREEN DATA		
Diameter - Inches <b>4"</b>	Length - Feet <b>10</b>	Slot Size - Inches <b>.020</b>
Screen Type <b>Sch 40 PVC</b>	Depth to Bottom - Feet <b>83'</b>	

GEOLOGIC DATA (Office Use Only)			
Surface Elev.	Geologic Unit	Unit Thickness	Depth to Top
Subs. SWL	Date	Analysis	Aquifer Test
Driller's Remarks			
Top of Lap Pipe or Reduction in Casing FEET    IF TELESCOPED OR MORE THAN ONE SCREEN: USE BACK PAGE			

DESCRIPTION OF FORMATIONS ENCOUNTERED	FROM	TO
<b>TOP So: 1</b>	<b>0</b>	<b>5</b>
<b>Chalk</b>	<b>5</b>	<b>25</b>
<b>Sand &amp; Gravel</b>	<b>25</b>	<b>83</b>

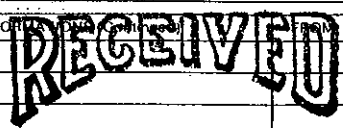

**AUG 08 1994**

Dept. of Environmental Quality  
Office of Land & Water Resources

IF MORE SPACE IS NEEDED, USE BACK