


Adams
F 71
4-68

MISSISSIPPI
BOARD OF WATER COMMISSIONERS
416 North State Street
Jackson, Mississippi 39201

CODED

WATER WELL DRILLERS LOG

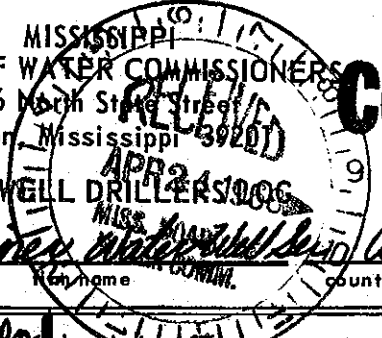

4-22 1968 Haney Water Well Dr. Adams
date well completed name county well located

LANDOWNER: <u>Wamba Assoc. Inc.</u>	Description of formations encountered	from
<u>P.O. Box 1448</u>	<u>top soil</u>	<u>0</u>
<u>Natchez, Mississippi</u>	<u>clay</u>	<u>2'</u>
(mailing address)	<u>fine sand</u>	<u>17'</u>
	<u>course sand</u>	<u>130'</u>

WELL LOCATION:
sec. 10-T-30N R-4-E
10 miles South of Natchez
(distance) (direction) (nearest town)

WELL PURPOSE: home
(home, irrigation, municipal, industrial)

- WELL COMPLETION DATA:
- (1) diameter (inches) 2"
 - (2) total depth (feet) 150'
 - (3) static water level (feet) 19' below above top of ground.
 - (4) casing 2" S&S, 140'
(material) (depth)
2" If telescope see back.
(size)
 - (5) screen 10", 140'
(length) (depth to top)
2", S.S.
(size) (material)
 - (6) pump 2 10
(HP) (yield gpm)
electric
(type power)
 - (7) electric log No.
(yes or no)

(organization running log)
 - (8) how well bottom plugged wood
plug

CODED

APR 15 1968
MISS. BOARD OF WATER COMMISSIONERS



DRILLERS REMARKS: