

ADAMS
F80
6-11-81

MISSISSIPPI DEPARTMENT OF NATURAL RESOURCES
Bureau of Land and Water Resources
Southport Mall
P.O. Box 10631
Jackson, Mississippi 39209
WATER WELL DRILLERS LOG

CODE

6-11-81 date well completed Rayburn Drill. & Const. Co. firm name Adams county well located

LANDOWNER:
Rayco Drilling Co.
Natchez, Ms. 39120
(mailing address)

description of formations encountered	from	to
Top soil	0	2
Clay	2	85
Sand	85	14
Shale	145	18
Sand	185	28
Shale	285	28
Sand	388	38


WELL LOCATION:
sec. 16 T. 60 N R. 3 E
2 mi. miles South of Natchez
(distance) (direction) of (nearest town)

WELL PURPOSE:
(home, irrigation, municipal, industrial)

fr NE/Cor Sec. 15 of N 47
th E @ RA 262' to loc.

- WELL COMPLETION DATA:
- diameter (inches) 3"
 - total depth (feet) 388'
 - static water level (feet) 124' below top of ground.
 - casing Blk 388' 362'
(material) (depth)
3" if telescope see back.
(size)
 - screen 20' 362'
(length) (depth to top)
3" Slotted Pipe
(size) (material)
 - pump 50 gpm
(HP) (yield gpm)
(type power)
 - electric log no
(yes or no)
(organization running log)
 - how well bottom plugged wood plug

DRILLERS REMARKS:

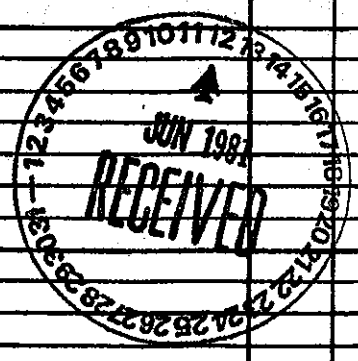

0000001