

**F**  
**8-22-60**

Not in use  
**WATER WELL DRILLERS LOG**

F-301  
**CODED**

Date: 8/22, 1960, Driller: C. RIVER WATER WELLS, county ADAMS  
(Name)

|  | Description & Color of Materials<br>Sand, Clay, Red Clay, Shell, etc. | Thick-<br>ness<br>Feet |
|--|---|------------------------|
| (1) Owner of Land: <u>CLOVERDALE WATER WORKS</u><br>(Name)<br><u>NATCHEZ, MISS.</u><br>(Address) | TOP SOIL  | 0-7 1/2                |
| (2) Location: <u>1/4, 1/4, Sec. T R</u>  | BROWN CLAY  | 2-4                    |
| <u>2</u> miles <u>SOUTH</u> of <u>NATCHEZ</u><br>(distance) (direction) (Nearest Town)           | GRAVEL  | 110-1                  |
| (3) Topography: <u>HILLY</u><br>(Hilly) (Flat) (Level)   | GRAY CLAY   | 100-1                  |
| (4) Purpose of Well: <u>HOME</u><br>(Domestic Irrigation, Municipal, Industrial, Other)          | SAND  | 118-2                  |
|  | SAND & GRAVEL   | 210-2                  |

Information upon completion of well:

- (1) Diameter 6 inches.
- (2) Total Depth 252 feet.
- (3) Water Level 154 feet below top of ground.
- (4) Cased to 232, Size 6"
- (5) Screen: Size 6", Length 20 FT.
- (6) Were any formations sealed against pollution?  
no


If YES depth of formation \_\_\_\_\_

Why \_\_\_\_\_

Drillers Remarks: \_\_\_\_\_

Adams Co Water Assn  
baught Sept 1960

**CODED**

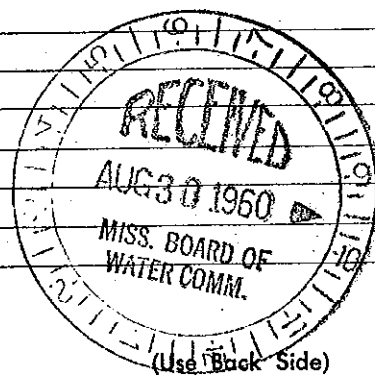

copy to Board of Water Commissioners 429 Miss. St. Jackson, M