

ADAMS MISSISSIPPI BOARD C.

F 2003
2-27-61

WATER WELL DRILLERS LOG

C, F or A

Date: 2/27, 1961, Driller: C. River Water Well Serv. Co. Adams County, Adams (Name)

(1) Owner of Land: DeWITT Lowrey
(Name)
Brea Dr Rd Natchez
(Address)

(2) Location: $\frac{1}{4}$, $\frac{1}{4}$, Sec. T R
2 miles South, of Natchez
(distance) (direction) (Nearest Town)

(3) Topography: Hilly
(Hilly) (Flat) (Level)

(4) Purpose of Well: Home
(Domestic Irrigation
Municipal, Industrial, Other)

Description & Color of Materials Sand, Clay, Red Clay, Shell, etc.	Thick- ness Feet	De- p- th Feet
TOP SOIL	0-3	3
Red clay	3-14	14
GRAY CLAY	14-40	40
Blue clay	40-120	120
SAND	120-170	170

Information upon completion of well:

(1) Diameter 2 inches.

(2) Total Depth 175 feet.

(3) Water Level 115 feet below top of ground.

(4) Cased to 168', Size 2"


(5) Screen: Size 2, Length 5'

(6) Were any formations sealed against pollution?
 yes, no.

If YES depth of formation

Why

Drillers Remarks:

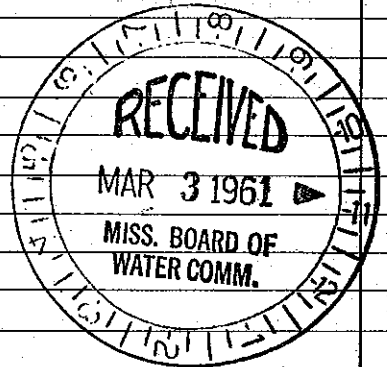

(Use Back Side)

Mail this copy to Board of Water Commissioners 429 Miss. St. Jackson, Miss.

Well No.