

ADAMS MISSISSIPPI BOARD OF WATER COMMISSIONERS
 F 2006
 5-16-66 WATER WELL DRILLERS LOG

Date: 5/16, 1966, Driller: C. RIVER WATER WELL SERVICE County ADAMS
 (Name)

(1) Owner of Land: <u>Lugene Goussier</u> (Name)	Description & Color of Materials Sand, Clay, Red Clay, Shell, etc.	Thick- ness Feet	Dr F
<u>61 South Natchez</u> (Address)	<u>TOP SOIL</u>	<u>1</u>	<u>1</u>
(2) Location: <u>1/4</u> , <u>1/4</u> , Sec. <u>T</u> <u>R</u>	<u>CLAY</u>	<u>87</u>	<u>8</u>
<u>6</u> miles <u>South</u> , of <u>Natchez</u> (distance) (direction) (Nearest Town)	<u>FINE SAND</u>	<u>22</u>	<u>11</u>
(3) Topography: <u>HILLY</u> (Hilly) (Flat) (Level)	<u>COURSE SAND</u>	<u>40</u>	<u>16</u>
(4) Purpose of Well: <u>HOME</u> (Domestic Irrigation Municipal, Industrial, Other)			


Information upon completion of well:

- (1) Diameter 4 inches.
- (2) Total Depth 150 feet.
- (3) Water Level 87 feet below top of ground.
- (4) Cased to 140, Size 4"
- (5) Screen: Size 4", Length 10 FT.
- (6) Were any formations sealed against pollution?
 yes, no.

If YES depth of formation _____

Why _____

Drillers Remarks: _____

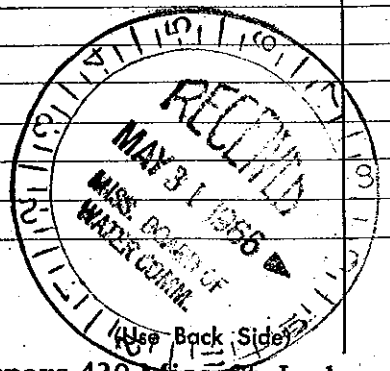

Mail this copy to Board of Water Commissioners 429 Miss. St. Jackson, M