

Adams
R 2014

MISSISSIPPI DEPARTMENT OF NATURAL RESOURCES
 Bureau of Land and Water Resources
 Southport Mall
 P.O. Box 10631
 Jackson, Mississippi 39209
WATER WELL DRILLERS LOG

Aug 5 1987 River City Water Well Adams
 date well completed firm name county well located


LANDOWNER: Tom Husman
Natchez Ms
Husman Oil Co.
 (mailing address)

description of formations encountered	from	to
Top Soil	0	2
Chalk	20	6
Chalk & Sand	60	8
Sand	80	140
Chalk	120	1
Sand Fine & C.	130	1
Coarse Sand	140	1

WELL LOCATION:
 sec. 6 T. 6 N. R. 3 E.
6 miles South of Natchez
 (distance) (direction) (nearest town)

WELL PURPOSE: Home
 (home, irrigation, municipal, industrial)

- WELL COMPLETION DATA:
- diameter (inches) 4"
 - total depth (feet) 160'
 - static water level (feet) 20 ^{below} above top of ground.
 - casing PVC, 140'
 (material) (depth)
4"
 (size) If telescope see back.
 - screen 20', 140'
 (length) (depth to top)
4", PVC
 (size) (material)
 - pump 3 40
 (HP) (yield gpm)
Electric
 (type power)
 - electric log No
 (yes or no)
- (organization running log)
- (8) how well bottom plugged Backwash
Packed & Valve

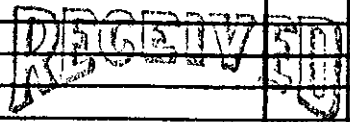

Department of Natural Resources
 Bureau of Land & Water Resources

DRILLERS REMARKS: