

ADAMS MISSISSIPPI BOARD OF WATER COMMISSIONERS

G 8

5-13-66

WATER WELL DRILLERS LOG

**CODED**

Date: 5/13, 1966, Driller: Grimes Water Well Drilling County Adams  
(Name)

(1) Owner of Land: <u>Adams Co Water Ass.</u> <small>(Name)</small>	Description & Color of Materials Sand, Clay, Red Clay, Shell, etc.	Thick- ness Feet	Depth Feet
<u>Natchez Miss.</u> <small>(Address)</small>	<u>TOP SOIL</u>	<u>1</u>	<u>1</u>
(2) Location: <u>1/4, 1/4, Sec. 41 T<sup>14</sup> R<sup>14</sup></u>	<u>CLAY</u>	<u>33</u>	<u>34</u>
<u>5</u> miles <u>SOUTH</u> of <u>Natchez</u>	<u>SAND</u>	<u>110</u>	<u>124</u>
<small>(distance) (direction) (Nearest Town)</small>	<u>Blue Clay</u>	<u>98</u>	<u>222</u>
(3) Topography: <u>Hilly</u>	<u>Coarse Sand &amp; Gravel</u>	<u>45</u>	<u>267</u>
<small>(Hilly) (Flat) (Level)</small>			
(4) Purpose of Well: <u>Community</u> <small>(Domestic Irrigation Municipal, Industrial, Other)</small>			

Information upon completion of well:


- (1) Diameter 10 inches.
- (2) Total Depth 267 feet.
- (3) Water Level 62 feet below top of ground.  
217
- (4) Cased to 222, Size 10
- (5) Screen: Size 6", Length 50 FT.
- (6) Were any formations sealed against pollution?  
no.

If YES depth of formation \_\_\_\_\_

Why \_\_\_\_\_

Drillers Remarks: new address  
RT. 5 Box 98  
Natchez Miss.

*Two wells at same place and just alike*

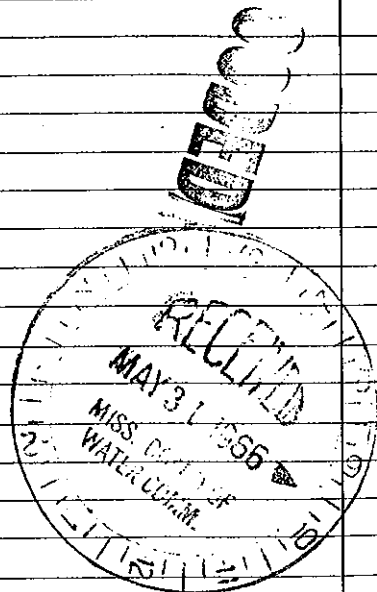

(Use Back Side)

Mail this copy to Board of Water Commissioners 429 Miss. St. Jackson, Miss.

Well No.