



STAMM-SCHLEE, INC.

P. O. Box 230


RAYNE, LOUISIANA, 70578

WELL RECORD

Type of Well Municipal Date January 15, 1973
 Owner Adams Co. Water Association Well No. One
 Address Natchez, Mississippi Rig Used # 6
 Well Location Green Field Road
 Date Drilling Started May 29, 1973 Date Completed June 27, 1973
 Total Depth of Well 600 ft. Size of Well _____
 Static Water Level 340 ft. Driller Louis Dugas

EACH STRATUM FROM - TO	DEPTH OF STRATA	FORMATIONS FOUND IN EACH STRATUM
0 - 8	8	Red Sand & Clay
8 - 28	20	Light Gravel
28 - 57	29	Clay
57 - 183	126	Coarse Sand & Small Gravel
183 - 203	20	Clay & Gravel Mix
203 - 282	79	Clay
282 - 355	73	Hard Clay
355 - 374	19	Sandy Clay
374 - 490	116	Clay
490 - 500	10	Very Fine Sand & Silt
500 - 520	20	Medium Sand
520 - 553	33	Medium Sand & Coarse Sand
* 553 - 562	9	Medium Sand & Coarse Sand with Clay
* 562 - 600	38	Clay
	600	T. D.

AS BUILT DRAWING OF WELL

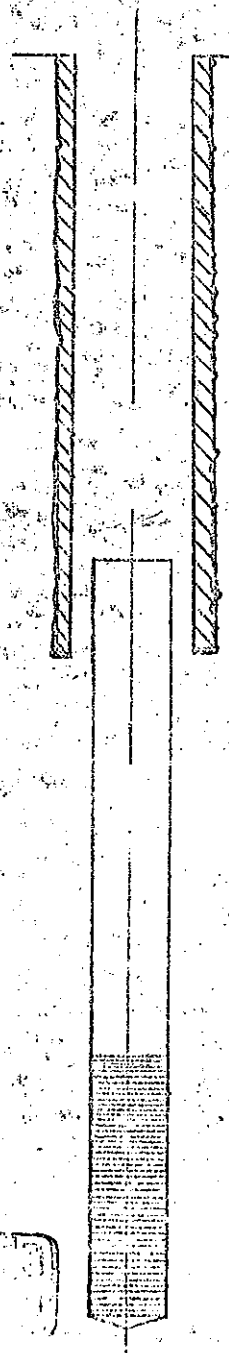

FEB 25 1974