	$_1$ State We	ll Report	
County: Adams	Pai		For Office Use Only:
	Mississippi Department of	of Environmental Quality	Aquifer:
Permit #:	P.O. Bo	1 Water Resources x 10631	Well #:70
Driller: Dary Naylor	Jackson, MS		L. S. Elevation:
Date drilling completed: 430 09		51-5210	E-log #:
	J ` ´	6938 (fax)	
State Law requires that this rep	ort be prepared by the d	riller in detail and filed w	vith the Department within
30 days of completion of drilling Well Owner Inform	ation	Wel	l Location
Wher Name Pan Goda	~d	Latitude: ° '	_" Longitude:'
· · · · · · · · · · · · · · · · · · ·			
Mailing Address: 100 Hun	tersLane	Method of Lat/Long (circle o	ne): Conventional Survey,
		USGS quad, Hand-held	1 GPS, Survey-grade GPS
	<u>US 39120</u>	14 14 Sec_ 4	5 Twn 6N Rng 2W
0.0	ate Zip Code	Distance Direction	Nearest Town
Telephone No. (601) 446 - 89	43	$\underline{-9}_{\text{Miles}}$	of Kingstor
	Well Da	ata	
Purpose of Well (circle one) Home In	dustrial Public Supply	Irrigation Fish Culture	Other:
		ell drilling completed:	1/20/09
-			
If flowing, method of flow regulation: V	alve Other (de	scribe)	
Static Water Level: <u>135</u> feet a	above of below (circle one) la	nd surface Date measured	4/30/09
Hole depth: <u>190</u> Well d	lepth: <u>190'</u>	Well grouted to a depth of	<u> </u>
Type of grout (circle one): Cement	Bentonite Mix		
10.0	sing diameter:	_inches Type of casing:	PVC
			0.10
Screen length: <u>20</u> feet Sc	reen diameter:	_inches Type of screen:	
Screen slot size: <u>1010</u> inches	Setting depth: From	<u></u>	190feet
Type of completion (circle all applicable): Gravel packed Underr	eamed Telescoped Ope	n hole Natural Development
Top of lap pipe or reduction in casing:			
_			
Logs run (circle all applicable): No log	run) Electric Gamma Ray	Density Sonic Neutron	Other:
Name of organization running log(s): I certify that the well was drilled, cons			
Department of Environmental Quality	and/or the Mississippi Dep	artment of Health regulation	ns and state laws.
RAYBORN DRILLING, INC.	0-60		
Print Name of Water Well Contractor ar	nd License No.	Signature	of Water Well Contractor
			RECE
			C & Stream Vager Darmer C
			MAY 2 0

	e tra Coloradores e colorador e a constructiva	
	an de Caral de La companya de	
1.43W	sa, ⊉Californati agn. 2600€€0017 Californati ant	
i 	a total a second second	
		and and an an an and an

 $\mathcal{L}_{\mathrm{press}} = \frac{1}{2} \sum_{i=1}^{n} \frac{1}{2$

in the second s

a se a compañía de presidente por	n in de la gebaat O	10-200 R9	an a	antido. (新生产的 - 11 - 11 - 11 - 11 - 11 - 11 - 11 -
•	in a characteristic de table es	in fan earder de sta		· ···· · ···· ··· · ··· · ··· · ··· ··	an an tright and
	· · · · · · · · · · · · · · · · · · ·	, tati na di tati j	······································		
	and the second				
	and and a second se		. •		
	<u>х</u> ана.	· · · ·			
· · · · · · · · · · · · · · · · · · ·	and the second				
	······································		a de la companya de l	<u>ъ.</u> ,	
	and the second se				
the second			$(1,2,\ldots,n) \in \{1,2,\ldots,n\}$		
	ar <u>in in in arte de la com</u>	· • • • • • • • • • • • • • • • • • • •			en e
والمتحد فوالوالعا متدامه	and a second		والمرور المرووف والمراجع والم	en e	
		an <mark>bs:</mark> kresnaula	្លាំ (ស្ត្រី) () សុខ សារ សារាសារសារ ស្ត្រី	AN DMILLING, 19	ODYAT
		en e		n Franziski se	for 2015 1 2017

	STATE W	ELL REPORT	
County: <u>Adams</u> Permit #: Driller: <u>GaryRaybc</u>	Pump Installer Mississippi Departme Office of Land P.O. Jackson, J	Part 2 Pump Installer's Completion Report Mississippi Department of Environmental Quality Office of Land and Water Resources P.O. Box 10631 Jackson, MS 39289-0631	
Date completed:)961-5210 54-6938 (fax)	Elevation:
	ared by the pump installer in deta	ail and filed with the Departme	nt within 30 days of the
installation of pump. Well Owner	Information	We	Il Location
Owner Name: Pam	Godard	Latitude:	_Longitude:
Mailing Address: 00	Huntershane	Method of Lat/Long (circle or	ne): Conventional Survey,
Natchez US 3912 City State Zip Code Telephone No. (601) 446-8943		USGS quad, Hand-held GPS, Survey-grade GPS <u>4</u> 4 Sec <u>46</u> Twn <u>6 N Rng 200</u> Distance Direction Nearest Town <u>9 Miles E of King Stor</u>	
	b Type le one		ower Type Circle one
Air Lift Jet	Submersible	Diesel Engine Gasoli	ne Engine Natural Gas
Bucket Piston	Turbine	Electric Motor Hand	Tractor PTO
Centrifugal Rotary	Flowing Well		(specify):
Other (specify):	20/00	Horse Power Rating of Motor Setting Depth:	<u>- Ι-ΗΡ</u>
Date Pump Installed:4		Setting Depth:/	<u> </u>
ī	Fest Data 30 09		easuring Water Level
Static Water Level (A): 135			asuring Line Steel Tape
Pumping Water Level (B):	Feet Below Land Surface	Other (specify):	
Drawdown [(B) – (A)]:		10	shut in head:feet
Test Pumping Rate: (Gallons Per Minute	Well yielded 0	GPM with a drawdown of
Duration of Pump Test (minimum	n 4 hours):hours	feet after	hours of pumping
I HEREBY CERTIFY that the al	bove statements are true to the best 060	t of my knowledge.	
Print Name of Pump Installer an		Signature of Pump	Installer RECEI

BY: OLWR


G-48

If well telescopes please sketch below and show depths.

Ground Level

Description of Formations Encountered	From	To
CHALK	0	50
GRAVEL	50	120
COARSE SAND + PEUGRAVEL	120	160
COURSE SAND	160	190
		<u> </u>
		<u> </u>

If more than one screen, show location of each on sketch

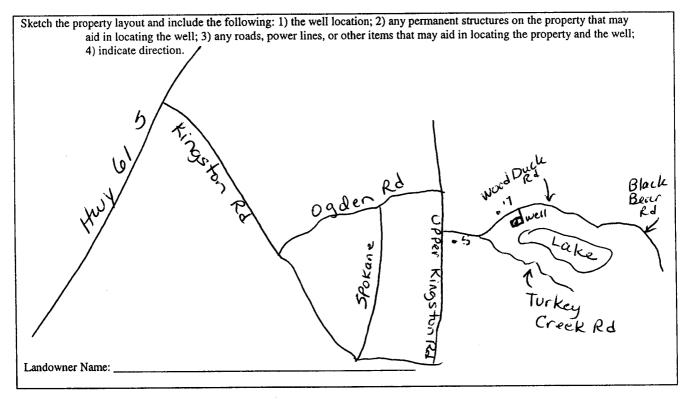

Signature of Water Well Contractor

RECEIVED MAY 2 0 2009 BY: OLWR