

ADAMS MISSISSIPPI BOARD OF WATER

G 2000

WATER WELL DRILLERS LOG

8-15-60

Date: 8/15, 1960, Driller: CRIDER WATER WELL County ADAMS

(Name)

		Description & Color of Materials Sand, Clay, Red Clay, Shell, etc.	Thick- ness Feet	Depth Feet
(1) Owner of Land: <u>PERCY E. SIMMONS</u> (Name)		TOP SOIL	0-6	6
<u>Route 3 Box 321 Natchez</u> (Address)		GRAY CLAY	5-15	15
(2) Location: <u>1/4</u> , <u>1/4</u> , Sec. <u>T R</u>		SAND	15-80	80
<u>6</u> miles <u>S-E</u> , of <u>Natchez</u> (distance) (direction) (Nearest Town)		GRAY CLAY	80-84	84
(3) Topography: <u>HILLY</u> (Hilly) (Flat) (Level)		SAND	84-154	154
(4) Purpose of Well: <u>Home</u> (Domestic Irrigation Municipal, Industrial, Other)				


Information upon completion of well:

- (1) Diameter 2 inches.
- (2) Total Depth 154 feet.
- (3) Water Level 94 feet below top of ground.
- (4) Cased to 147, Size 2"
- (5) Screen: Size 2", Length 5'
- (6) Were any formations sealed against pollution?
no.

If YES depth of formation _____

Why _____

Drillers Remarks: _____

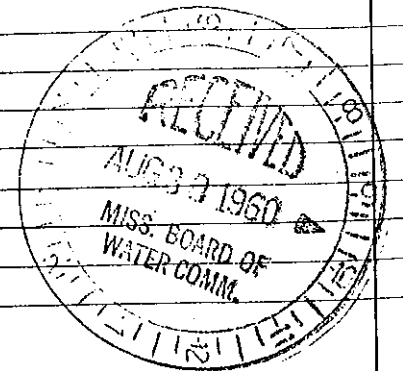

(Use Back Side)

Well No.

Mail this copy to Board of Water Commissioners 429 Miss. St. Jackson, Miss.