


**ADAMS**  
**G 2001**

**WATER WELL DRILLERS L.**

Date: 10-11-60, 1960, Driller: C. R. Riden <sup>5042</sup> Waterwell <sup>8</sup> County Adams  
 (Name)

(1) Owner of Land: <u>Risher Well Service</u> (Name)	Description & Color of Materials Sand, Clay, Red Clay, Shell, etc.	Thick- ness Feet	Depth Feet
<u>Liberty Rd.</u> (Address)	<u>TOP SOIL</u>	<u>0-5</u>	<u>5</u>
(2) Location: <u>1/4</u> , <u>1/4</u> , Sec. <u>1</u> T. <u>R.</u>	<u>BROWN CLAY</u>	<u>5-40</u>	<u>40</u>
<u>4</u> miles <u>South</u> of <u>Natchez</u> (distance) (direction) (Nearest Town)	<u>GRAY CLAY</u>	<u>40-75</u>	<u>75</u>
(3) Topography: <u>Hilly</u> (Hilly) (Flat) (Level)	<u>SAND</u>	<u>75-105</u>	<u>105</u>
(4) Purpose of Well: <u>Company Uses</u> (Domestic Irrigation Municipal, Industrial, Other)	<u>Blue clay</u>	<u>105-219</u>	<u>219</u>
	<u>SAND &amp; GRAVEL</u>	<u>219-237</u>	<u>237</u>
Information upon completion of well:			
(1) Diameter <u>4</u> inches.			
(2) Total Depth <u>237</u> feet.			
(3) Water Level <u>141</u> feet below top of ground.			
(4) Cased to <u>222</u> , Size <u>4"</u>			
(5) Screen: Size <u>1/2"</u> , Length <u>15'</u>			
(6) Were any formations sealed against pollution? <u>no</u>			
If YES depth of formation _____			
Why _____			
Drillers Remarks: _____			
_____			
_____			
_____			

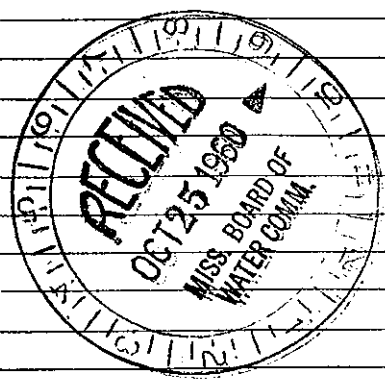

(Use Back Side)

Well No.

Mail this copy to Board of Water Commissioners 429 Miss. St. Jackson, Miss