


ADAMS
G 2003
11-5-60

BOARD OF WATER COMMISSIONERS
WATER WELL DRILLERS LOG

Date: 11/5/60, 1960, Driller: GRAND WATER WELL SERV County ADAMS
 (Name)

(1) Owner of Land: <u>V.C. Etheridge</u> (Name)	Description & Color of Materials Sand, Clay, Red Clay, Shell, etc.	Thick- ness Feet	Depth Feet
<u>Ogden Rd. Natchez MISS</u> (Address)	<u>TOP SOIL</u>	<u>0-2</u>	<u>2</u>
(2) Location: <u>1/4, 1/4, Sec. T R</u>	<u>Red clay</u>	<u>2-12</u>	<u>12</u>
<u>7</u> miles <u>S-E</u> of <u>Natchez</u> (distance) (direction) (Nearest Town)	<u>GRAVEL</u>	<u>12-15</u>	<u>15</u>
(3) Topography: <u>HILLY</u> (Hilly) (Flat) (Level)	<u>GRAY CLAY</u>	<u>15-21</u>	<u>21</u>
(4) Purpose of Well: <u>HOME</u> (Domestic Irrigation Municipal, Industrial, Other)	<u>SAND</u>	<u>21-25</u>	<u>25</u>
Information upon completion of well:			
(1) Diameter <u>2</u> inches.			
(2) Total Depth <u>217</u> feet.			
(3) Water Level <u>130</u> feet below top of ground.			
(4) Cased to <u>210</u> , Size <u>2"</u>			
(5) Screen: Size <u>2"</u> , Length <u>5'</u>			
(6) Were any formations sealed against pollution? <u>no</u>			
If YES depth of formation _____			
Why _____			
Drillers Remarks: _____			

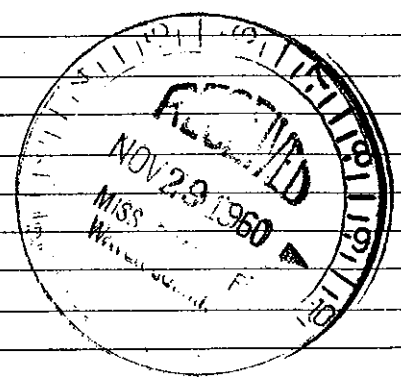

(Use Back Side) Well No. _____
 Mail this copy to Board of Water Commissioners 429 Miss. St. Jackson, Miss