
	State V	ell Report	
County: Alams	Part 1 – Driller's Log For Office Use Only:		For Office Use Only:
1	Mississippi Department of Environmental Quality Aqui		Aquifer:
Permit #:		nd Water Resources	Well #:
Driller: Water Well Drilling	P.O. Box 2309 Jackson, MS 39225		
Date drilling completed: 11-17-07	(601)961- 5210		L. S. Elevation: H45
Date drining completed.	(601)96	1- 5228 (fax)	E-log #:
State Law requires that this report	be prepared by the lic	ense holder responsible for i	
Department at the above address			
Information on Well Owner		Well or Bo	rehole Location
(Landowner if borehole is not for a water well)		Latitude: N . 31 .28.4	1 26 Longitude: W. 91, 12. 15
Owner Name Wallace Willand			
		Method of Lat/Long (circle of	ne): Conventional Survey,
Mailing Address: 8 Roytiz Rol		USGS quad, Hand-held	GPS: Survey-grade GPS
		8 1/ W 1/ Sec 4/	2 Tur St Rng WV
<u>Noyie</u> City State	5 39661	IR IR 49	Twn 51 Rng WV 6N Nearest Town of <u>Ng 4chc 2</u> .
City State	e Zip Code	IR IR Direction	Nearest Town
Telephone No. (601) 445 470	5	Miles	or Matche L.
	Well / Bor	chole Data	
Date drilling started: 11 - 14-07 Date dril	ling completed: <u>11-1</u>	7-07 Hole depth: 90	Hole diameter: 7
Location of the source of any surface water	used for drilling:	Potuble untier	
Location of the source of any surface water Method of dosing and volume of Chlorine	used in drilling and deve	lopment:	
Logs run (circle all applicable): (No log run Name of organization running log(s):			
Purpose of borehole (check one): Water We	II Geotechnical/Geol	ogical Investigation Ground	Source Heat Pump
Seismic S	urvey Other (<i>describe</i>	?)	
		n, skip the remainder of this bl	ock
Purpose of Well (check one): Home In	dustrial Public Supply	y Irrigation Fish Culture	Other:
If a flowing well, method of flow regulation	: Valve 0	other (describe)	
Static Water Level: <u>45</u> feet abo	ove or below (circle one)	and surface Date measured:	11-17-07
Method of Measurement (circle one) ste	el tape electric tape	air line other:	
Well depth: <u>90</u> Well grouted to a dep	th of <u></u> feet Type	e of grout (circle one): Neat Cerr	Bentonite Mix
Casing length: 70 feet Casing	g diameter:4	inches Type of casing:	PVC
Screen length: <u>20</u> feet Scree	n diameter:	inches Type of screen:	PVC
Screen slot size:inches			<u>feet</u>
Type of completion (circle all applicable):	\sim		hole Natural Development
	Other (describe):	·	
Top of lap pipe or reduction in casing:	feet. If te	lescoped or more than one scre	en, describe on next page
· · · · · · · · · · · · · · · · · · ·			Form: OLWR-SWR-1A (04/08)

• ;

RECEIVED 0CT 17 2008 BY: OLWR




The sketch below only required for water wells

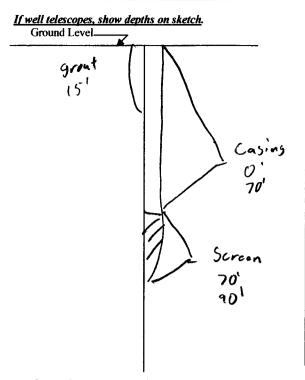

Description of Formations Encountered	From (depth)	To (depth)
Top Soil Clay	Ground Level	2
Clav	2	43
Sand	43	90
		-
	ļ	
	1	
	1	· · · · · ·
		L

wells and boreholes, unless specifically exempted by regulations

If more than one screen, show location of each on sketch

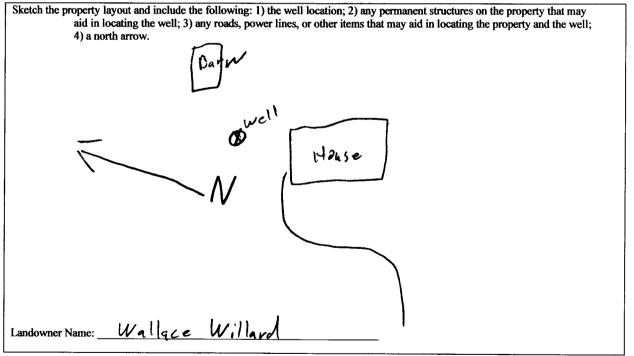

Form: OLWR-SWR-1A (04/08)

I certify that the well/borehole was drilled, constructed, and completed in accordance with all applicable requirements of the Mississippi Department of Environmental Quality and the Mississippi Department of Health regulations, if applicable, and state laws.

Water Well Drilling 0681 11-17-07 Jage M Print Name of Responsible Licensee and License No. Date Signature of J

Signature of Licensee

RECEIVED OCT 17 2008 BY: OLWR

STATE W	ELL REPORT
County: Adams Permit #: Pump Installer Driller: Water Well Dri'lling Date completed: 11-17-07	Part 2 's Completion Report nt of Environmental Quality and Water Resources . Box 2309 n, MS 39225 .)961-5210 61-5228 (fax) For Office Use Only: Aquifer: HAS Well #: Elevation: <i>contractor or a licensed pump installer. A copy of Part 1 of the</i>
$\frac{R_{exic}}{City} \frac{M_5}{State} \frac{9461}{2ipCode}$ Telephone No. (60) 445 - 4705	USGS quad, Hand-held GPS, Survey-grade GPS $\begin{array}{c} & & & \\ & & & & \\ & & & \\ & & & & & \\$
Pump Type Circle one Air Lift Jet Submersible Bucket Piston Turbine Centrifugal Rotary Flowing Well Other (specify):	Power Type Circle one Diesel Engine Gasoline Engine Natural Gas Electric Motor Hand Tractor PTO Windmill Other (specify):
Pump Test Data Pump Test Data Date Well Tested: $11 - 17 - 07$ Static Water Level (A): 45 Feet Below Land Surface Pumping Water Level (A): 45 Feet Below Land Surface Pumping Water Level (B): 76 Feet Below Land Surface Drawdown [(B) - (A)]: 1 Feet Below Land Surface Test Pumping Rate: 10 Gallons Per Minute	Method of Measuring Water Level Circle one Air Line Electric Measuring Line Steel Tape Other (specify):

• •

BY: OLWR