

Emery #1

County: Adams
 Permit #: _____
 Driller: Gary Rayborn
 Date drilling completed: 4/7/13

State Well Report

Part 1

Mississippi Department of Environmental Quality
 Office of Land and Water Resources
 P.O. Box 10631
 Jackson, MS 39289-0631
 (601)961-5210
 (601)354-6938 (fax)

For Office Use Only:
 Aquifer: _____
 Well #: H48
 L. S. Elevation: _____
 E-log #: _____

State Law requires that this report be prepared by the driller in detail and filed with the Department within 30 days of completion of drilling of the well.

Well Owner Information	Well Location
Owner Name: <u>D + D Drilling Inc</u>	Latitude: <u>31° 29' 51"</u> Longitude: <u>91° 7' 18"</u>
Mailing Address: <u>P.O. Box 1634</u>	Method of Lat/Long (circle one): <u>Conventional Survey</u>
<u>Ferriday LA 71334</u>	USGS quad, Hand-held GPS, Survey-grade GPS
City State Zip Code	<u>IR ¼ IR ¼ Sec 38' Twn 6N Rng 1W</u>
Telephone No. <u>(318) 757-3274</u>	Distance Direction Nearest Town
	<u>2.3 Miles SW of Jeannette</u>

Well Data

Purpose of Well (circle one) Home Industrial Public Supply Irrigation Fish Culture Other: Rig Supply

Date well drilling started: 4/5/13 Date well drilling completed: 4/7/13

If flowing, method of flow regulation: Valve _____ Other (describe) _____

Static Water Level: 165' feet above or below (circle one) land surface Date measured: 4/7/13

Method of Measurement (circle one) steel tape electric tape air line other: _____

Hole depth: 260' Well depth: 260' Well grouted to a depth of 10 feet

Type of grout (circle one): Cement Bentonite Mix

Casing length: 240 feet Casing diameter: 4 inches Type of casing: PVC

Screen length: 20 feet Screen diameter: 4 inches Type of screen: PVC

Screen slot size: .020 inches Setting depth: From 240 feet to 260 feet

Type of completion (circle all applicable): Gravel packed Underreamed Telescoped Open hole Natural Development

Other (describe): _____

Top of lap pipe or reduction in casing: _____ feet. If telescoped or more than one screen, describe on back of page

Logs run (circle all applicable): No log run Electric Gamma Ray Density Sonic Neutron Other: _____

Name of organization running log(s): _____

I certify that the well was drilled, constructed, and completed in accordance with all applicable requirements of the Mississippi Department of Environmental Quality and/or the Mississippi Department of Health regulations and state laws.

RAYBORN DRILLING, INC.

0-60

Print Name of Water Well Contractor and License No.

Signature of Water Well Contractor

RECEIVED

APR 11 2013

BY: OLWR

If well telescopes please sketch below and show depths.

Ground Level

Description of Formations Encountered


From To

Blank area for sketching well telescopes and depths.

Description of Formations Encountered	From	To
CHALK	0	20
GRAVEL	20	65
CHALK	65	175
Fine SAND and SILT	175	215
MEDIUM SAND	215	260

If more than one screen, show location of each on sketch

Sketch the property layout and include the following: 1) the well location; 2) any permanent structures on the property that may aid in locating the well; 3) any roads, power lines, or other items that may aid in locating the property and the well; 4) indicate direction.

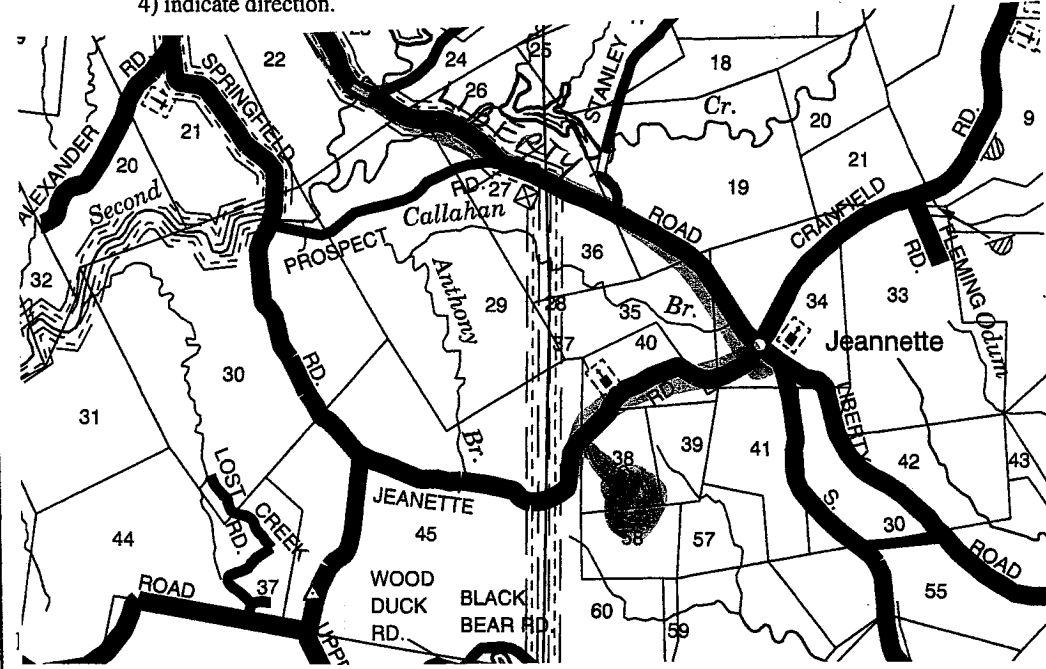

[Handwritten signature]

Signature of Water Well Contractor

RECEIVED

APR 11 2013

BY: OLWR

STATE WELL REPORT

Emery #1

County: Adams
Permit #: _____
Driller: Gary Rayborn
Date completed: 4/7/13

Part 2
Pump Installer's Completion Report
Mississippi Department of Environmental Quality
Office of Land and Water Resources
P.O. Box 10631
Jackson, MS 39289-0631
(601)961-5210
(601)354-6938 (fax)

For Office Use Only:
Aquifer: _____
Well #: H48
Elevation: _____

This report should be prepared by the pump installer in detail and filed with the Department within 30 days of the installation of pump.

Well Owner Information	Well Location
Owner Name: <u>D + D Drilling, Inc.</u>	Latitude: <u>31° 29' 57"</u> Longitude: <u>91° 4' 10"</u>
Mailing Address: <u>P.O. Box 1634</u>	<u>28 37</u> <u>15 23</u> Method of Lat/Long (circle one): Conventional Survey,
<u>Ferriday LA 71334</u>	USGS quad, Hand-held GPS, Survey-grade GPS
City State Zip Code	<u>1/4</u> <u>1/4</u> Sec <u>38</u> Twn <u>6N</u> Rng <u>1W</u>
Telephone No. <u>(318) 757-3274</u>	Distance Direction Nearest Town <u>2.3</u> Miles <u>SW</u> of <u>Jeannette</u>

Pump Type Circle one	Power Type Circle one
Air Lift Jet <u>Submersible</u>	Diesel Engine Gasoline Engine Natural Gas
Bucket Piston Turbine <u>Electric Motor</u>	Hand Tractor PTO
Centrifugal Rotary Flowing Well	Windmill Other (specify): _____
Other (specify): _____	Horse Power Rating of Motor: <u>5 HP</u>
Date Pump Installed: <u>4/7/13</u>	Setting Depth: <u>210</u> feet
Rated Pump Capacity: <u>60</u> Gallons Per Minute	Number of Stages: <u>11</u>

Pump Test Data	Method of Measuring Water Level Circle one
Date Well Tested: <u>4/7/13</u>	Air Line <u>Electric Measuring Line</u> Steel Tape
Static Water Level (A): <u>165</u> Feet Below Land Surface	Other (specify): _____
Pumping Water Level (B): _____ Feet Below Land Surface	For flowing well, measured shut in head: _____ feet
Drawdown [(B) - (A)]: _____ Feet Below Land Surface	Well yielded <u>60</u> GPM with a drawdown of
Test Pumping Rate: <u>60</u> Gallons Per Minute	_____ feet after _____ hours of pumping
Duration of Pump Test (minimum 4 hours): _____ hours	

I HEREBY CERTIFY that the above statements are true to the best of my knowledge.

RAYBORN DRILLING, INC. 0-60
Print Name of Pump Installer and License No. (if applicable)

[Signature]
Signature of Pump Installer

RECEIVED

APR 11 2013

BY: OLWR