


F T 2000

10-12-60

WATER WELL DRILLERS LOG

Date: 10/12, 1960, Driller: CRINEA WATERWELL ⁵⁰²⁰¹ County: ADAMS
(Name)

	Description & Color of Materials Sand, Clay, Red Clay, Shell, etc.	Thick- ness Feet	Depth Feet
(1) Owner of Land: <u>R.C. BELK</u> (Name)	<u>TOP SOIL</u>	<u>0-7</u>	<u>4</u>
<u>WATCHEZ MISS.</u> (Address)	<u>Red clay</u>	<u>4-15</u>	
(2) Location: <u>1/4</u> , <u>1/4</u> , Sec. <u>5N 3W</u> T <u>R</u>	<u>CLAY CLAY</u>	<u>15-140</u>	
<u>7</u> miles <u>SOUTH</u> , of <u>WATCHEZ</u> (distance) (direction) (Nearest Town)	<u>SAND</u>	<u>140-175</u>	
(3) Topography: <u>HILLY</u> (Hilly) (Flat) (Level)			
(4) Purpose of Well: <u>HOME</u> (Domestic Irrigation Municipal, Industrial, Other)			
Information upon completion of well:			
(1) Diameter <u>2</u> inches.			
(2) Total Depth <u>175</u> feet.			
(3) Water Level <u>132</u> feet below top of ground.			
(4) Cased to <u>168</u> , Size <u>2"</u>			
(5) Screen: Size <u>2"</u> , Length <u>5'</u>			
(6) Were any formations sealed against pollution?			
_____ yes, <u>X</u> no.			
If YES depth of formation _____			
Why _____			
Drillers Remarks: _____			

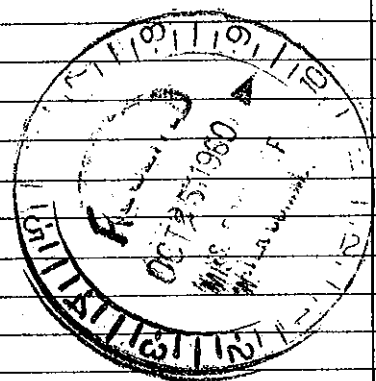

(Use Back Side)

Well No.