

ADAMS

COMMISSIONERS

J 2001

10-13-60

WATER WELL DRILLERS LOG

Date: 10/17, 1960, Driller: ^{SEAN} CRIVER WATERWELL County ADAMS

(Name)

(1) Owner of Land: <u>HEWARD PRITCHARD</u> (Name)	Description & Color of Materials Sand, Clay, Red Clay, Shell, etc.	Thick- ness Feet	Depth Feet
<u>NATCHEZ</u> (Address)	<u>TOP SOIL</u>	<u>0-3</u>	<u>3</u>
<u>5N 3W</u>	<u>BROWN CLAY</u>	<u>3-18</u>	<u>18</u>
(2) Location: <u>1/4</u> , <u>1/4</u> , Sec. <u>T</u> <u>R</u>	<u>GRAY CLAY</u>	<u>18-87</u>	<u>87</u>
<u>6</u> miles <u>SOUTH</u> of <u>NATCHEZ</u> (distance) (direction) (Nearest Town)	<u>SAND</u>	<u>87-133</u>	<u>133</u>
(3) Topography: <u>Hilly</u> (Hilly) (Flat) (Level)			
(4) Purpose of Well: <u>Home</u> (Domestic Irrigation Municipal, Industrial, Other)			


Information upon completion of well:

- (1) Diameter 2 inches.
- (2) Total Depth 133 feet.
- (3) Water Level 115 feet below top of ground.
- (4) Cased to 126, Size 2"
- (5) Screen: Size 2", Length 15'
- (6) Were any formations sealed against pollution?
no

If YES depth of formation _____

Why _____

Drillers Remarks: _____

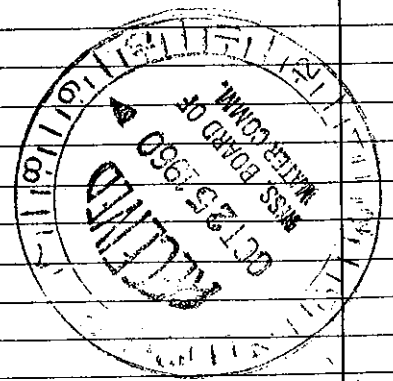

(Use Back Side)

Well No.

Mail this copy to Board of Water Commissioners 429 Miss. St. Jackson, Miss