

ADAMS

EX 5 2002

WATER WELL DRILLERS LOG

11-8-60

Date: 11/8/1960, Driller: GRINER WATER WELL SEED County ADAMS
 (Name)

(1) Owner of Land: <u>MARIO BARONI JR.</u> (Name)	Description & Color of Materials Sand, Clay, Red Clay, Shell, etc.	Thick- ness Feet	Depth Feet
<u>61 South Natchez Miss</u> (Address)	<u>TOP SOIL</u>	<u>0-4</u>	<u>4</u>
(2) Location: <u>1/4, 1/4, Sec. T R</u>	<u>BROWN CLAY</u>	<u>4-12</u>	<u>12</u>
<u>7</u> miles <u>South</u> , of <u>Natchez</u> (distance) (direction) (Nearest Town)	<u>Red CLAY</u>	<u>12-20</u>	<u>20</u>
(3) Topography: <u>Hilly</u> (Hilly) (Flat) (Level)	<u>GRAY CLAY</u>	<u>20-70</u>	<u>70</u>
(4) Purpose of Well: <u>Home</u> (Domestic Irrigation Municipal, Industrial, Other)	<u>SAND</u>	<u>70-133</u>	<u>133</u>


Information upon completion of well:

- (1) Diameter 2 inches.
- (2) Total Depth 133 feet.
- (3) Water Level 72 feet below top of ground.
- (4) Cased to 126, Size 2"
- (5) Screen: Size 2", Length 5'
- (6) Were any formations sealed against pollution?
 yes, no.

If YES depth of formation _____

Why _____

Drillers Remarks: _____

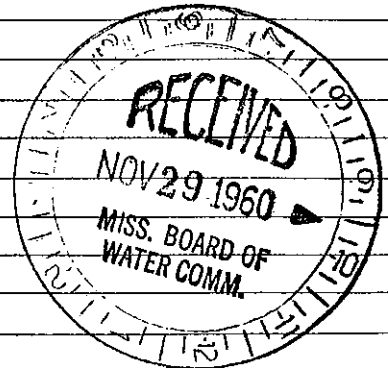

(Use Back Side)

Well No.

Mail this copy to Board of Water Commissioners 429 Miss. St. Jackson, Miss