

MISSISSIPPI DEPARTMENT OF NATURAL RESOURCES

Bureau of Land and Water Resources

Southport Mall

P.O. Box 10631

Jackson, Mississippi 39209

WATER WELL DRILLERS LOG

CODED

Adams
K 14
3/25/81

3-25 19 81 Rayborn Drill. & Const. Co. Adams
date well completed firm name county well located

LANDOWNER: #1 Egypt.
Energy Drill. Co.
Natchez, Ms.
(mailing address)


WELL LOCATION:
sec. 8 T. 5 N. R. 2 E.
3 miles East of Sibley
(distance) (direction) (nearest town)

WELL PURPOSE:
(home, irrigation, municipal, industrial)

WELL COMPLETION DATA:
(1) diameter (inches) 3"
(2) total depth (feet) 575'
(3) static water level (feet) 200' ^{below} _{above} top of ground.
(4) casing Blk. 575'
(material) (depth)
3" if telescope see back.
(size)
(5) screen 20'
(length) (depth to top)
(size) (material)
(6) pump 40 GPM
(HP) (yield gpm)
(type power)
(7) electric log no
(yes or no)
(organization running log)
(8) how well bottom plugged wood Plug

description of formations encountered	from	to
top soil	0	3
clay	3	60
shale	60	88
sand CODED	88	125
shale	125	140
sand	140	215
shale	215	225
sand	225	305
shale	305	520
sand	520	575

Sw/ly Sec. 5 on E 1/4 of S 1/4 of Sec. 5 For 950' N. 1/4 of RA
70' to loc.

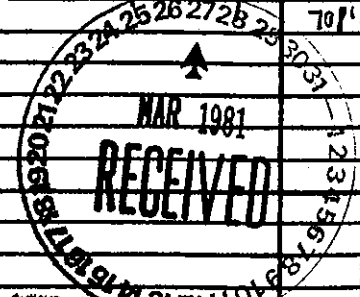

DEPT. OF NATURAL RESOURCES
BUREAU OF LAND & WATER RESOURCES

MAR 27 1981

RECEIVED

DRILLERS REMARKS: