31-23-	29		
· 91-20-			
State W	ell Report		
MOLD - O-D- Adams P	art 1	For Office Use Only:	
	t of Environmental Quality	Aquifer: <u>42</u>	
Permit #: Office of Land a	nd Water Resources	Well #:	
	lox 10631		
Jackson, In	IS 39289-0631 961-5210	L. S. Elevation:	
	4-6938 (fax)	E-log #:	
State Law requires that this report be prepared by the	driller in detail and filed w	ith the Department within	
30 days of completion of drilling of the well. Well Owner Information	Wel	Location	
0			
Owner Name Sligo Plantation	Latitude: 31 . 27 , 49 " Longitude: 91. 21. 23		
Mailing Address: 522 Main St	Method of Lat/Long (circle one): Conventional Survey,		
	USGS quad, Hand-held	I GPS, Survey-grade GPS	
Natchez MS 39120 City State Zip Code	IP1/1 TP 1/4 Sec 21	$_{\text{Twn}} \underline{5N}_{\text{Rng}} \underline{2W}$	
City State Zip Code			
Telephone No. ()	Miles	of Si Dien	
Well	Data		
Weil .	Data		
Purpose of Well (circle one Home Industrial Public Supply	Irrigation Fish Culture	Other:	
Date well drilling started: $4 - 27 - 10$ Date well drilling completed: $4 - 27 - 10$			
If flowing, method of flow regulation: Valve Other (describe)			
Static Water Level: <u>120</u> feet above on below (circle one)	land surface Date measured	4-21-10	
Method of Measurement (circle one) steel tape electric tap	e air line other:	· · · · · · · · · · · · · · · · · · ·	
Hole depth: <u>200'</u> Well depth: <u>200'</u>	Well grouted to a depth of	feet	
Type of grout (circle one): Cement Bentonite Mix		D I C	
Casing length: 180 feet Casing diameter: 4 inches Type of casing: PVC			
Screen length: <u>20</u> feet Screen diameter: <u>4</u> inches Type of screen: <u>PVC</u>			
Screen slot size: <u>1010</u> inches Setting depth: From <u>180</u> feet to <u>200</u> feet			
Type of completion (circle all applicable): Gravel packed Underreamed Telescoped Open hole Natural Development			
Other (describe):	······		
Top of lap pipe or reduction in casing:feet. If	telescoped or more than one se	creen, describe on back of page	
Logs run (circle all applicable); No log run Electric Gamma Ray Density Sonic Neutron Other:			
Name of organization running log(s):			
I certify that the well was drilled, constructed, and completed in	accordance with all applicabl	le requirements of the Mississippi	
Department of Environmental Quality and/or the Mississippi Department of Health regulations and state laws.			
Raybon Drilling Inc. 160		2-10-	
Print Name of Water Well Contractor and License No.	Signature	of Water Well Contractor	
		and the second	
		Service States	
		·••	

.

CV: CLIVE


Pump Installer's	LL REPORT rt 2 Completion Report		
County Mississippi Department	of Environmental Quality d Water Resources Aquifer: K42		
P.O. B	Dx 10631 S 39289-0631 Well #:		
$A Q \gamma \Box Q D \qquad (601)9$	61-5210 Elevation:		
This report should be prepared by the pump installer in detail	and filed with the Department within 30 days of the		
installation of pump. Well Owner Information	Well Location		
Owner Name: Sligo Plantation	Latitude:Longitude:		
Mailing Address:	Method of Lat/Long (circle one): Conventional Survey,		
522 Main St	USGS quad, Hand-held GPS, Survey-grade GPS		
Notchez MS 39120	<u>1414 Sec 21 Twn 5N Rng 2W</u>		
City State Zip Code	Distance Direction Nearest Town		
Telephone No. ()	<u>Miles</u> <u>e</u> of <u>Sibley</u>		
Ритр Туре	Power Type		
Circle one	Circle one		
Air Lift Jet Submersible	Diesel Engine Gasoline Engine Natural Gas		
Bucket Piston Turbine	Electric Motor Hand Tractor PTO		
Centrifugal Rotary Flowing Well	Windmill Other (specify):		
Other (specify):	Horse Power Rating of Motor: H		
Date Pump Installed: 5-1-10	Setting Depth:feet		
Rated Pump Capacity: Gallons Per Minute	Number of Stages: [ L]		
Pump Test Data	Method of Measuring Water Level Circle one		
Date Well Tested: 5-1-10	Church Trans		
Static Water Level (A): <u>120</u> Feet Below Land Surface	Air Line (Electric Measuring Line) Steel Tape Other (specify):		
Pumping Water Level (B):Feet Below Land Surface	Other (specify):		
Drawdown [(B) – (A)]:Feet Below Land Surface	For flowing well, measured shut in head:feet		
Test Pumping Rate: Gallons Per Minute	Well yielded GPM with a drawdown of		
Duration of Pump Test (minimum 4 hours):hours	feet afterhours of pumping		
I HEREBY CERTIFY that the above statements are true to the bes Gary Rayborn 0-60	st of my knowledge.		
Print Name of Pump Installer and License No. (if applicable)	Signature of Fundy motimer		

If well telescopes please sketch below and show depths.



Description of Formations Encountered	From	To
Chalk	0	35
Pea Gravel	35	39
Chalk	39	120
Medium SAND	120	200
		<u> </u>
		<u>+</u>
		<u> </u>
		<u> </u>
		<u> </u>
		+
		+
	1	

If more than one screen, show location of each on sketch

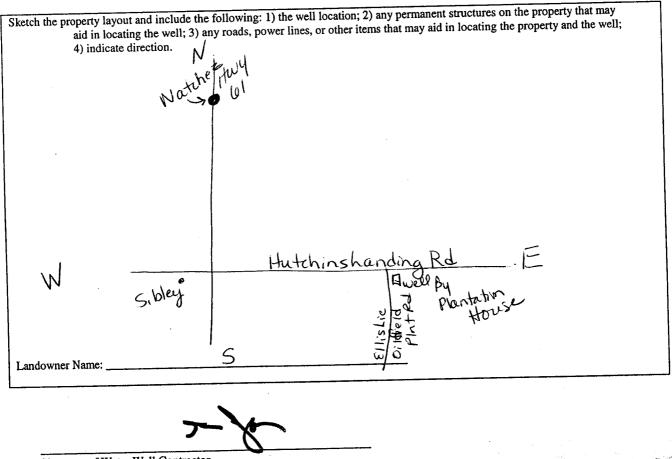

Signature of Water Well Contractor

K42