

K ADAMS  
2000

WATER WELL DRILLERS LOG ?

10-29-60

Date: 10/29, 1960, Driller: PRINCE WATERWELL SER. County ADAMS

(Name)

(1) Owner of Land: <u>FARNEST DAVIDSON</u> (Name)	Description & Color of Materials Sand, Clay, Red Clay, Shell, etc.	Thick- ness Feet	Depth Feet
<u>KINGSTON RD. NATCHEZ, MISSISSIPPI</u> (Address) <u>SN 2W</u>	<u>TOP SOIL</u>	<u>0 TO 4</u>	
(2) Location: <u>1/4, 1/4, Sec. T R</u>	<u>RED CLAY</u>	<u>4-17</u>	
<u>9</u> miles <u>S-EAST</u> of <u>NATCHEZ</u> (distance) (direction) (Nearest Town)	<u>GRAY CLAY</u>	<u>17-27</u>	
(3) Topography: <u>HILLY</u> (Hilly) (Flat) (Level)	<u>SAND</u>	<u>77-115</u>	
(4) Purpose of Well: <u>HOME</u> (Domestic Irrigation Municipal, Industrial, Other)			


Information upon completion of well:

- (1) Diameter 4' inches.
- (2) Total Depth 115 feet.
- (3) Water Level 84 feet below top of ground.
- (4) Cased to 105, Size 4"
- (5) Screen: Size 4", Length 10'
- (6) Were any formations sealed against pollution?  
no

If YES depth of formation \_\_\_\_\_

Why \_\_\_\_\_

Drillers Remarks: \_\_\_\_\_

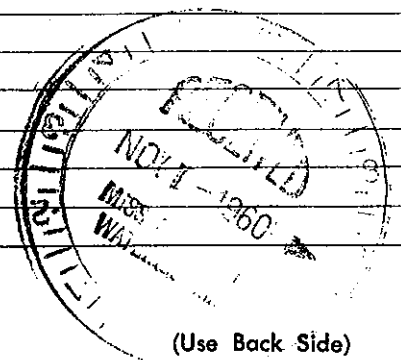

(Use Back Side)

Well No.

Mail this copy to Board of Water Commissioners 429 Miss. St. Jackson, Miss