

ADAMS
K 2006

MISSISSIPPI DEPARTMENT OF NATURAL RESOURCES
Bureau of Land and Water Resources
Southport Mall
P.O. Box 10631
Jackson, Mississippi 39209
WATER WELL DRILLERS LOG

June 29 1987 River City Water Well Adams
date well completed firm name county well located


LANDOWNER:
Energy Drilling Co.
413 W. 1st St. Natchez Ms
(mailing address)

WELL LOCATION:
sec. 8 T. 4 N R. 2 E
8 5 S miles South of Natchez
(distance) (direction) (nearest town)

WELL PURPOSE: Supply
(home, irrigation, municipal, industrial)

- WELL COMPLETION DATA:
- (1) diameter (inches) 3"
 - (2) total depth (feet) 147'
 - (3) static water level (feet) 50' below top of ground.
 - (4) casing PVC, 137' (material) (depth)
(size) if telescope see back.
 - (5) screen 10' 137' (length) (depth to top)
3" PVC (size) (material)
 - (6) pump (HP) (yield gpm)
Air (type power)
 - (7) electric log No (yes or no)
No (organization running log)
 - (8) how well bottom plugged Well has been pulled & plugged

| description of formations encountered | from | to |
|---------------------------------------|------|-----|
| Chalk | 0 | 60 |
| Blue Chalk | 60 | 80 |
| Fine Sand | 80 | 100 |
| Fine & coarse mix | 100 | 140 |
| Coarse Sand | 140 | 147 |

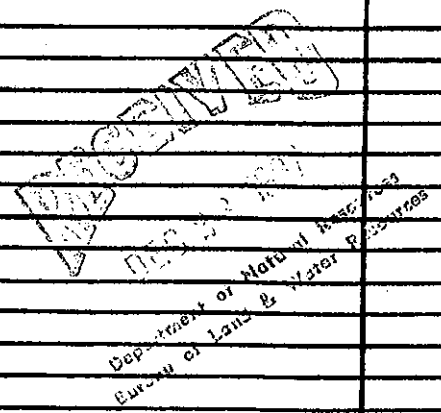

DRILLERS REMARKS: