

ADAMS
L 17
7-1-81

MISSISSIPPI DEPARTMENT OF NATURAL RESOURCES
Bureau of Land and Water Resources
Southport Mall
P.O. Box 10631
Jackson, Mississippi 39209
WATER WELL DRILLERS LOG

CODED

2-1 1981 Rayborn Drill & Const. Co. Adams
date well completed firm name county well located

LANDOWNER:
Reata Drilling Co.
Natchez, Ms.
(mailing address)


description of formations encountered	from	to
Top soil	0	2
Sand	2	75
Shale	75	350
Sand	350	350

WELL LOCATION:
sec. 9 T 5 S R 1 E
8 miles NE of Kingston
(distance) (direction) (nearest town)

WELL PURPOSE:
(home, irrigation, municipal, industrial)

- WELL COMPLETION DATA:
- diameter (inches) 3"
 - total depth (feet) 350'
 - static water level (feet) _____ below above top of ground.
 - casing Blk 330'
(material) (depth)
3" (size) if telescope see back.
 - screen 20' 330'
(length) (depth to top)
3" (size) Blk Silted Pipe (material)
 - pump _____ 50 Gpm
(HP) (yield gpm)
_____ (type power)
 - electric log no
(yes or no)
_____ (organization running log)
 - how well bottom plugged Wood Plug

CODED

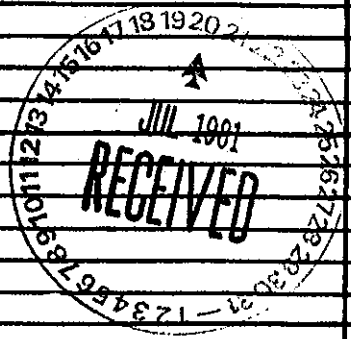

DRILLERS REMARKS: