

ADAMS MISSISSIPPI BOARD OF WATER COMMISSIONERS

L 2000


2-300

WATER WELL DRILLERS LOG

7-23-60

Date: July 23, 1960, Driller: Harding Sevenson, Adams County, Miss.

(1) Owner of Land: <u>L. B. Mc MANUS</u> (Name)	Description & Color of Materials Sand, Clay, Red Clay, Shell, etc.	Thick- ness Feet	Depth Feet
<u>Rt 1 Natchez, Miss.</u> (Address) <u>SN 1 W</u>	<u>Red Clay</u>	<u>20'</u>	<u>0</u>
(2) Location: <u>1/4</u> , <u>1/4</u> , Sec. <u>T</u> , <u>R</u>	<u>Sand &amp; Red Gravel</u>	<u>160'</u>	<u>20</u>
<u>3</u> miles <u>East</u> of <u>Kingston</u> (distance) (direction) (Nearest Town)			
(3) Topography: <u>✓</u> (Hilly) (Flat) (Level)			
(4) Purpose of Well: <u>Domestic</u> (Domestic Irrigation Municipal, Industrial, Other)			
Information upon completion of well:			
(1) Diameter <u>4 3/4</u> inches.			
(2) Total Depth <u>180</u> feet.			
(3) Water Level <u>141</u> feet below top of ground.			
(4) Cased to <u>175'</u> , Size <u>2"</u>			
(5) Screen: Size <u>2"</u> , Length <u>5'</u>			
(6) Were any formations sealed against pollution? _____ yes, <u>✓</u> no.			
If YES depth of formation _____			
Why _____			
Drillers Remarks: _____			
_____			
_____			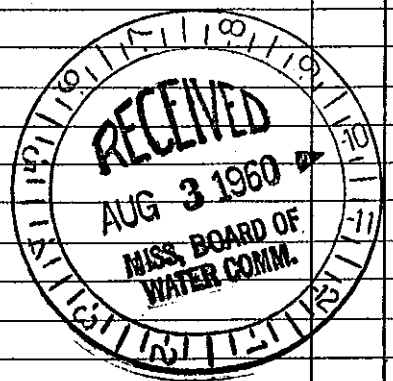
(Use Back Side)

Well No.

Mail this copy to Board of Water Commissioners 429 Miss. St. Jackson, Miss.