

MISSISSIPPI DEPARTMENT OF ENVIRONMENTAL QUALITY

Office of Land and Water Resources

P. O. Box 10631
Jackson, MS 39289-0631
WATER WELL DRILLERS LOG

COUNTY WELL LOCATED
Adams

WELL NUMBER CODED
L 2010

DATE WELL COMPLETED
8-19-99

PERMIT NUMBER
0-00

NAME OF DRILLING FIRM
Rayborn Drilling

NAME & MAILING ADDRESS OF LANDOWNER
William Kennedy
15827 Castle Ridge St.
Baton Rouge, LA 70817

WELL LOCATION SEC TOWNSHIP RANGE
28 5 S 1 E

DISTANCE DIRECTION NEAREST TOWN
4 Miles SE of Kingston

OTHER LANDMARK

WELL PURPOSE (Home) Irrigation, Municipal, Industrial, Fish Pond, etc.

PUMP DATA

PUMP TYPE (Circle One):
 Submersible Turbine, Jet, Flowing Well,
Other (Describe)

POWER TYPE (Circle One):
 Electric Tractor, Diesel, Gasoline, Butane,
Other (Describe) H/P 1

Pump Capacity (GPM)	No. of Stages	Setting Depth	FT.
<u>10</u>	<u>12</u>	<u>60</u>	

PUMP TEST

Well yielded _____ GPM with
a drawdown of _____ ft.
after _____ hours of pumping

WELL DATA

Well Depth	Casing Diameter (In.)	Casing Length (Ft.)
<u>401</u>	<u>4</u>	<u>381</u>
Type of Casing	Hole Depth	Depth to Static Water Level
<u>PVC</u>	<u>401</u>	<u>20</u>

TYPE OF COMPLETION: (Circle One or More):
 Gravel Packed Underreamed, Telescoped,
Natural Development, Open Hole, Other
(Describe)

WELL GROUTED TO A DEPTH OF 10 FEET
Type Grout (circle one): Cement, Bentonite, or Mix

SCREEN DATA

Diameter - Inches	Length - Feet	Slot Size - Inches
<u>4</u>	<u>20</u>	<u>.010</u>
Screen Type	Depth to Bottom - Feet	
<u>PVC</u>	<u>401</u>	

LOG DATA

TYPE OF LOG RUN (Circle One): No Log Run, Electric, Gamma Ray, Density, Sonic, Neutron, Other (Describe)

Name of Organization Running Log

GEOLOGIC DATA (Office Use Only)

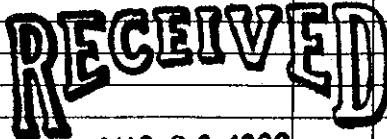
Surface Elev.	Geologic Unit	Unit Thickness	Depth to Top
Subs. SWL	Date	Analysis	Aquifer Test

Driller's Remarks

Top of Lap Pipe or Reduction in Casing

FEET IF TELESCOPED OR MORE THAN ONE SCREEN: USE BACK PAGE

DESCRIPTION OF FORMATIONS ENCOUNTERED	FROM	TO
Topsoil	0	3
Chalk	3	23
Sand	23	38
Chalk & Shale	38	350
Sand	350	401

FORMATIONS (Continued)	FROM	TO
 AUG 26 1999 Dept. of Environmental Quality Office of Land & Water Resources		
IF MORE SPACE IS NEEDED, USE BACK		